


LAND CORNER RECORDATION CERTIFICATE

Filing Requirement of Act 74, Mich. PA 1970

For Corners In: Lake _____ (County) _____	Located In T <u>19N</u> R <u>12W</u> E <u>6</u> T _____ R _____ E _____ S _____ T _____ R _____ S _____ T _____ R _____	Corner Code # _____ _____ _____ _____
1. Public Land Survey		
2. Property Controlling in Section		
3. Miscellaneous Property in Section		
4. Lot No: _____ Recorded Plat: _____		
5. Private Claims: _____		

Register of Deeds Stamp & File Number

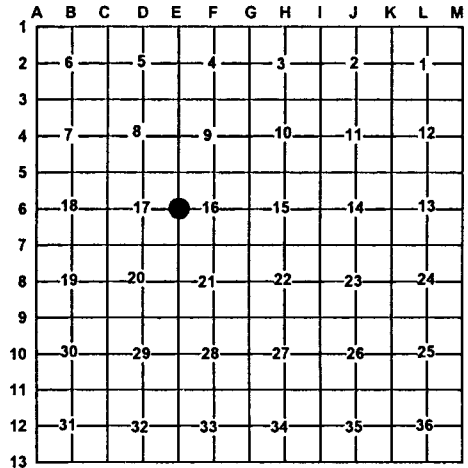

I, Craig W. McVean, in a field survey on May 2, 2001 do hereby state that under requirements of PA 74, Michigan PA of 1970, the corner points mentioned in lines 1 and 2 above were in conformance with regulations and rules therefore as required in the current manual of survey instructions of the United States Department of the Interior, Bureau of Land Management or by a decree of a Court of Law and/or that the corner points mentioned in lines 3, 4 and 5 above were in conformance with the rules of the Michigan Board of Land Surveyors or by a Decree of a Court of Law; established, re-established, monumented, recovered, found as expressed below:

NOTE: Not more than 2 corners, all in the same town and range, may be recorded on this certificate.

A. Description of original monument and accessories and/or subsequent restoration:

- E6 - GLO - Set ¼ post - S. Sibley - 1838
 Pine 14" N51°W 30 L.
 Maple 10" S51°E 8 L.
- LCRC - . 3, P. 426 - K.L. Ross - 1997
 Set ½" x 24" re-rod with cap #17634 by single proportion.
 W. Oak 10" N28°W 47.65'
 W. Pine 6" N16°E 49.74'
 W. Oak 7" S47°E 50.00'
 W. Pine 5" S30°W 34.91'
 Old RR Grade S. 200'

B. Description of corner evidence found and/or method applies in restoring or re-establishing corner:

- E6 - ¼ corner common to Sec. 16 & 17 - Fd. ½" x 24" CIR #17634 per Ross. Many Pine stps. in area but no markings. Previous DNR Survey work had S. Edge of Little Manistee River at 1557' to the N. of E6 vs. 2211' - GLO. ½" CIR accepted as a careful & faithful re-establishment of the position of the original corner.

C. Description of monument for corner and accessories established to perpetuate locating the position of the corner:

- E4 - Replaced ½" x 24" CIR #17634 with 4" DNR Alum. Cap on 1" x 36" Galv. Iron pipe.
 Reset Fd. steel fence post 1' N
 Set Blue Carsonite Post 1' SE
 S45°E 49.98' to Fd. nail in SW side 13" W. Oak Scribed 'XBT' (KLR)
 S23°W 34.87' to Fd. nail in E side 8" W. Pine Scribed 'XBT' (KLR)
 N16°W 47.65' to Fd. nail in E side 11" W. Pine Scribed 'XBT' (KLR)
 N14°E 49.87' to Fd. nail in W side 10" W. Pine Scribed 'XBT' (KLR)



Signed by: Craig W. McVean
 Surveyor's Michigan License No.: 39088

Date: 11/26/2001