

LAND CORNER RECORDATION CERTIFICATE

Filing Requirement of Act 74, Mich. PA 1970

For Corners In: Lake _____ (County) _____	Located In T 19N R 12W T _____ R _____	Corner Code # F5 _____ _____	
1. Public Land Survey	T 19N R 12W T _____ R _____	F5 _____ _____	
2. Property Controlling in Section	S _____ T _____ R _____ S _____ T _____ R _____	_____ _____	
3. Miscellaneous Property in Section	S _____ T _____ R _____ S _____ T _____ R _____	_____ _____	


Register of Deeds Stamp & File Number

4. Lot No: _____ Recorded Plat: _____

5. Private Claims: _____

I, **Craig W. McVean**, in a field survey on **June 18, 2001** do hereby state that under requirements of PA 74, Michigan PA of 1970, the corner points mentioned in lines 1 and 2 above were in conformance with regulations and rules therefore as required in the current manual of survey instructions of the United States Department of the Interior, Bureau of Land Management or by a decree of a Court of Law and/or that the corner points mentioned in lines 3, 4 and 5 above were in conformance with the rules of the Michigan Board of Land Surveyors or by a Decree of a Court of Law; established, re-established, monumented, recovered, found as expressed below:

NOTE: Not more than 2 corners, all in the same town and range, may be recorded on this certificate.

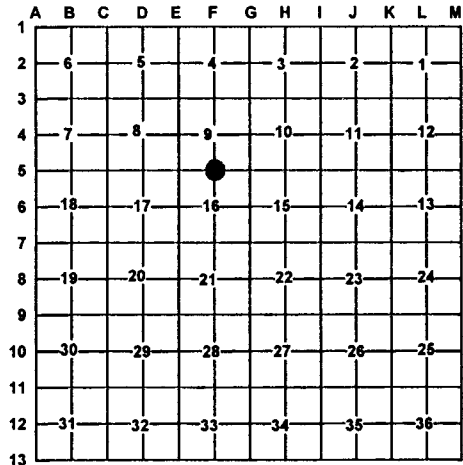

A. Description of original monument and accessories and/or subsequent restoration:

- F-5 G.L.O. Set 1/4 post -S. Sibley- 1838
 - Pine 8" S43°W 10 links
 - Pine 8" N10°E 17 links
- G. H. Johnson- map of North 1/2 of section 16
 - Popple 10" NW 6'
 - Popple 10" NE 21'
- Lakestate Surv. & Eng.- witness card
 - Set 1/2" rerod- 1985
 - 10" Maple N85°W 29.52'
 - 10" Cedar N44°E 24.00'
 - 6" and 10" twin Maple S57°E 29.70'
- Unrecorded survey- R. L. Wetherall- #609-90 -Same witnesses as Lakestate

B. Description of corner evidence found and/or method applies in restoring or re-establishing corner:

F-5 -1/4 corner common to Sec. 9 and 16- Retraced remains of old single strand of barb wire fence on ground that begins 33'± North of E-5. Traced the fence remains East 3300'± to wildlife planting. The fence remains being 31' to 41' North of a straight line between E-5 to G-5. At single proportional position for F-5 the fence remains are 40' ±2' North line. Searched for evidence of GLO and Johnson witnesses but found nothing conclusive. Johnson's map doesn't show section line dimensions, just ties South to the Little Manistee River which don't fit a straight line between E-5 and G-5, his ties to the river being some 45' to 100' shorter then our ties to the N. River bank. Johnson's survey map appears to be a timber cruise mostly to show swamp, streams and high ground. The barb wire being apparently laid out to be 33' North of the section line and probably the result of Johnson's survey. Thus set a 4" DNR aluminum cap on a 1" x 32" iron pipe midway between E5 & G5 at 7' N. of a straight line and 33'± South of the old East-West barb wire strand. Accepted DNR monument as best representing F-5 position per fence remains and Johnson's survey.;

-Reference point 'A' -N0°43'E 33.20' to found 1/2" rebar per Lakestate witnesses card in remains of the noted East-West barb wire fence. Being that I had mapped this fence as being 33'± North of E-5 and the section line as it goes East, I could not accept this 1/2" rebar as a correct representation of the F-5. 1/2" rebar not utilized this as F-5 this survey

C. Description of monument for corner and accessories established to perpetuate locating the position of the corner:

- F-5 -4" DNR aluminum cap on 1" X 32" galvanized iron pipe
 - North 1' to set blue carsonite post
 - N50°E 8.06' to set nail and tag in NW side of 5" W. Pine
 - S32°E 26.27' to set nail and tag in West side of 8" R. Pine scribed 'XBT'
 - S38°W 27.03' to set nail and tag in SW side of 7" R. Pine scribed 'XBT'
 - N55°W 30.61 to set nail and tag in NE side 4" W. Pine
 - N0°43'W 33.20' to 1/2" rebar- Reference point 'A'



Signed by: Craig W. McVean
 Surveyor's Michigan License No.: 39088

Date: 11/26/2001