

# LAND CORNER RECORDATION CERTIFICATE


Filing Requirement of Act 74, Mich. PA 1970

For Corners In: Lake _____ (County) _____	Located In T <u>19N</u> R <u>12W</u> T _____ R _____ S _____ T _____ R _____ S _____ T _____ R _____ S _____ T _____ R _____ S _____ T _____ R _____	Corner Code # <u>F7</u> _____ _____ _____ _____ _____
4. Lot No: _____	Recorded Plat: _____	
5. Private Claims: _____		

Register of Deeds Stamp & File Number

I, Craig W. McVean, in a field survey on May 2, 2001 do hereby state that under requirements of PA 74, Michigan PA of 1970, the corner points mentioned in lines 1 and 2 above were in conformance with regulations and rules therefore as required in the current manual of survey instructions of the United States Department of the Interior, Bureau of Land Management or by a decree of a Court of Law and/or that the corner points mentioned in lines 3, 4 and 5 above were in conformance with the rules of the Michigan Board of Land Surveyors or by a Decree of a Court of Law; established, re-established, monumented, recovered, found as expressed below:

**NOTE: Not more than 2 corners, all in the same town and range, may be recorded on this certificate.**

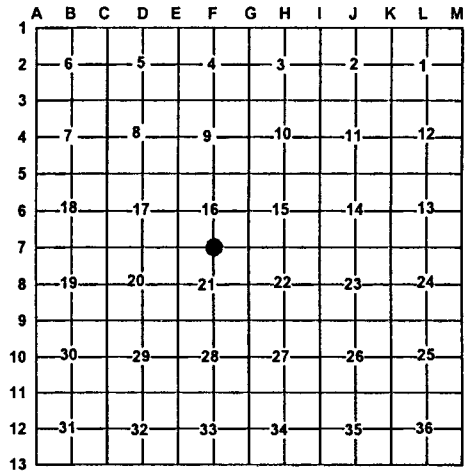

**A. Description of original monument and accessories and/or subsequent restoration:**

- |  |   |
|--|---|
| <p><u>F7</u> - <u>GLO</u> - set 1/4 post - S. Sibley - 1838.<br/>                 W. Oak 4" N24°W 55 L.<br/>                 W. Oak 4" S12°E 32 L.<br/>                 - G.H. Johnson - Dist. to G7-2627';<br/>                 Dist. to E7 - 2618'<br/>                 - G. Blass - 1960 - Fd. 1 1/4" pipe in center of Rd.<br/>                 E-W. 16" B. Oak S50°W 82.56' ;<br/>                 16" B. Oak N40°E 84.56';<br/>                 14" J. Pine N10°W 67.42'</p> | <p>- LCRC - L. 2, pg. 246- C.F. Roser - 1975 - set DNR mon. buried<br/>                 8" from 3 G. Blass wits.<br/>                 14" J. Pine N12°W 67.4' ; 13" B. Oak S40°E 50.3';<br/>                 17" B. Oak S50°W 82.3';<br/>                 Set Cedar post with location tag North 33'.</p> |
|--|---|

**B. Description of corner evidence found and/or method applies in restoring or re-establishing corner:**

F7 - 1/4 Corner Common to sec. 16 & 21- Fd. broken DNR Alum. cap on 1" Iron pipe per Roser. Measured 2631.74' (2627'- GHJ) to G7 & 2593.17' (2618'-GHJ) to E7.  
 Found remains or stps. of Blass & Rosers witnesses only that fit pipe. 1" Iron pipe accepted as the best available evidence to the position of the original corner

**C. Description of monument for corner and accessories established to perpetuate locating the position of the corner:**

F7 - Broken DNR Alum. cap in 1" iron pipe  
 N. 33' to set blue carsonite post with location tag  
 S28°W 63.66' to set N&T in SE side 6" J. Pine scribed 'XBT'  
 N16°W 70.54' to set N&T in W side 6" W. Pine scribed 'XBT'  
 N22°E 100.02' to set N&T in NW side 5" W. Pine scribed 'XBT'  
 S62°E 67.92' to set N&T in NE side 11" J. Pine scribed 'XBT'



Signed by: Craig W. McVean  
 Surveyor's Michigan License No.: 39088

Date: 11/26/2001