

STATE OF MICHIGAN
DEPARTMENT
OF
NATURAL RESOURCES

LAND CORNER RECORD


LAKE COUNTY
T 19 N R 13 W

DESCRIPTION OF CORNER West 1/16 on South line, Section 35

CORNER MONUMENT Set 1" x 36" pipe in ctr. of E-W trail road.

DATE MONUMENT PLACED AND WITNESSED 6-30-72

WITNESSES TO CORNER..... 6" Twn. Oak N 32 W 31.8'

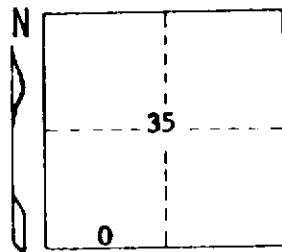

8" Oak N 33 E 18.4'


Cedar post with location tag Due N 33'

AND

CIRCLE CORNER REGISTERED

DESCRIPTION IN DETAIL AS TO HOW CORNER WAS LOCATED AND IDENTIFIED OR RESTORED.

Set by single proportion between Section corner W and 1/4 East. The West 1/16 corner on N line of Section 2 (T18N - R13W) is 4.44 ft. East.

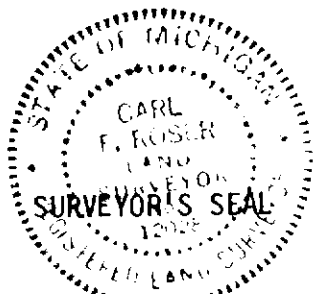

SIGNED

Carl F. Roser
REGISTERED LAND SURVEYOR 12028

DATE

7-7-72

DISTRIBUTION:

Forestry Division, Lansing