


STATE OF MICHIGAN  
DEPARTMENT  
OF  
NATURAL RESOURCES

LAND CORNER RECORD

LAKE COUNTY  
T 19 N R 13 W

DESCRIPTION OF CORNER West 1/16 on North line - Section 36  
CORNER MONUMENT Set 1"x36" pipe 1.5' S of E-W sand road Ctr. line buried 6"  
DATE MONUMENT PLACED AND WITNESSED 6-8-72  
WITNESSES TO CORNER..... Twin B. Oak 26" N 37 E 37.3'

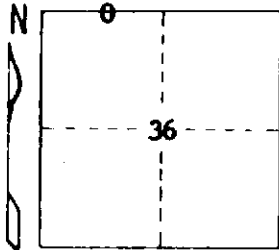


B. Oak 22" S 20 E 82.4'

AND

CIRCLE CORNER REGISTERED

DESCRIPTION IN DETAIL AS TO HOW CORNER WAS LOCATED AND IDENTIFIED OR RESTORED.

**Corner established per standard BLM instructions.**

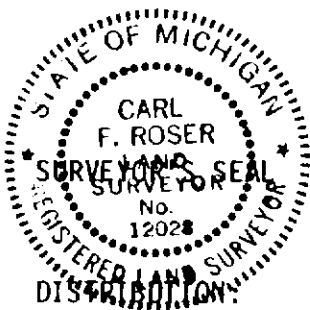

SIGNED

*Carl F. Roser*

DATE

7-15-72

REGISTERED LAND SURVEYOR 12028

Forestry Division, Lansing