

STATE OF MICHIGAN
DEPARTMENT
OF
NATURAL RESOURCES

LAND CORNER RECORD


LAKE COUNTY
T 19 N R 13 W

DESCRIPTION OF CORNER North 1/4 corner - Section 36

CORNER MONUMENT Found 1" x 18" pipe on Nly. edge rd. Added DNR monument, buried 1'

DATE MONUMENT PLACED AND WITNESSED 5-8-72

WITNESSES TO CORNER.....

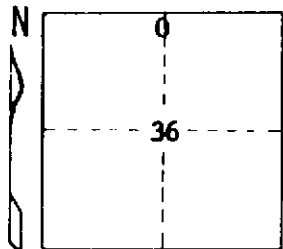

* B. Oak 10" S 20 E 59.1'

* B. Oak 12" N 40 E 49.0'

* B. Oak 9" N 70 W 35.6'


AND * CL sand road South 9'

CIRCLE CORNER REGISTERED

* G. Blass BT's

DESCRIPTION IN DETAIL AS TO HOW CORNER WAS LOCATED AND IDENTIFIED OR RESTORED.

Recovered Blass corner of record.

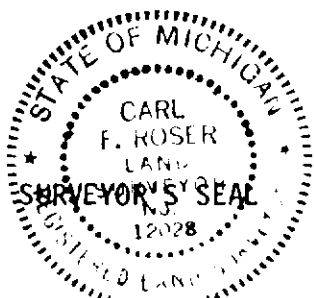

DISTRIBUTION:

Forestry Division, Lansing

SIGNED

Carl F. Roser

REGISTERED LAND SURVEYOR

12028

DATE

5-15-72