

STATE OF MICHIGAN  
DEPARTMENT  
OF  
NATURAL RESOURCES

LAND CORNER RECORD


LAKE COUNTY  
T 19 N R 13 W

DESCRIPTION OF CORNER South 1/4 corner - Section 36

CORNER MONUMENT Set DNR monument

DATE MONUMENT PLACED AND WITNESSED 6-8-72

WITNESSES TO CORNER..... B. Oak 15" S 40 W 30.9'

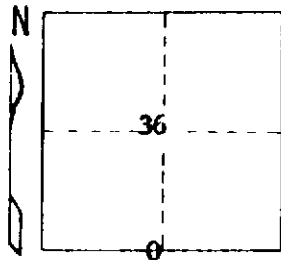

W. Pine 3" N 89 W 51.8'


W. Oak 15" N 02 E 29.8'

AND B. Oak 6" S 55 E 5.7'

CIRCLE CORNER REGISTERED

DESCRIPTION IN DETAIL AS TO HOW CORNER WAS LOCATED AND IDENTIFIED OR RESTORED.

**Corner re-established per standard BLM instructions.**

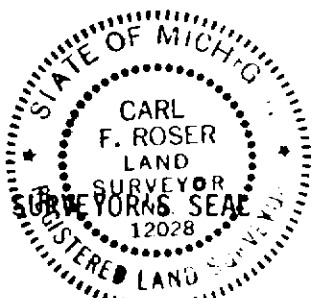

SIGNED

*Carl F. Roser*

DATE

6-15-72

DISTRIBUTION:

REGISTERED LAND SURVEYOR

12028

Forestry Division, Lansing