

STATE OF MICHIGAN
DEPARTMENT
OF
NATURAL RESOURCES

LAND CORNER RECORD


LAKE COUNTY
T 19 N R 13 W

DESCRIPTION OF CORNER NE corner - Section 36

CORNER MONUMENT Found 18" fencepost iron - added DNR monument

DATE MONUMENT PLACED AND WITNESSED 5-8-72

WITNESSES TO CORNER..... * Twin Oak 20" N 30 W 14.2'

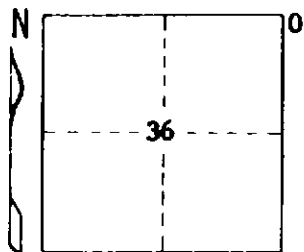

* Oak 12" N 55 E 17.9'

* Oak 12" S 20 E 29.4'

AND

CIRCLE CORNER REGISTERED * G. Blass BT's

DESCRIPTION IN DETAIL AS TO HOW CORNER WAS LOCATED AND IDENTIFIED OR RESTORED.

Recovered fencepost iron, fits U.S.B.T. remains.



DISTRIBUTION:

SIGNED

Carl F. Roser

DATE

5-15-72

REGISTERED LAND SURVEYOR 12028

Forestry Division, Lansing