

STATE OF MICHIGAN
DEPARTMENT
OF
NATURAL RESOURCES

LAND CORNER RECORD


LAKE COUNTY
T 19 N R 13 W

DESCRIPTION OF CORNER South 1/16 corner on East line - Section 36

CORNER MONUMENT Sat 1" x 36" pipe

DATE MONUMENT PLACED AND WITNESSED 6-9-72

WITNESSES TO CORNER..... B. Oak 15" N 08 E 27.2'

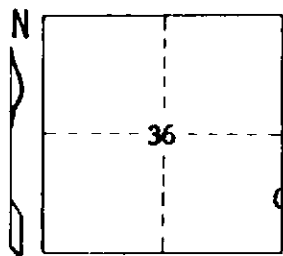

B. Oak 9" S 74 E 12.7'


W. Oak 11" S 50 W 20.9'

AND

CIRCLE CORNER REGISTERED

DESCRIPTION IN DETAIL AS TO HOW CORNER WAS LOCATED AND IDENTIFIED OR RESTORED.

Corner established per standard BLM instructions.

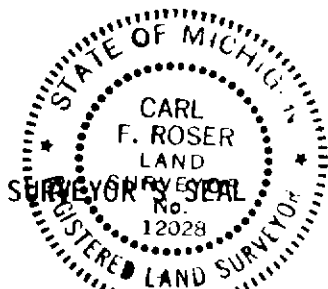

SIGNED

Carl F. Roser

DATE

6-16-72

DISTRIBUTION:

REGISTERED LAND SURVEYOR 12028

Forestry Division, Lansing