

STATE OF MICHIGAN
DEPARTMENT
OF
NATURAL RESOURCES

LAND CORNER RECORD


LAKE COUNTY
T 19 N R 13 W

DESCRIPTION OF CORNER East 1/4 corner - Section 36

CORNER MONUMENT Set DNR monument

DATE MONUMENT PLACED AND WITNESSED 6-9-72

WITNESSES TO CORNER..... W. Oak 9" N 05 E 9.4'

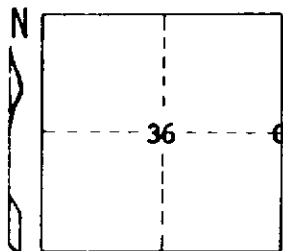

B Oak 15" S 25 E 36.7'


B. Oak 11" S 50 W 19.5'

AND

CIRCLE CORNER REGISTERED

DESCRIPTION IN DETAIL AS TO HOW CORNER WAS LOCATED AND IDENTIFIED OR RESTORED.

Corner re-established per standard BLM instructions.

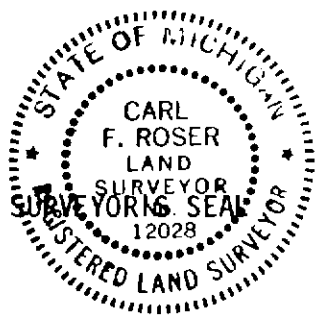

SIGNED

Carl F. Roser

DATE

6-16-72

DISTRIBUTION:

REGISTERED LAND SURVEYOR 12028

Forestry Division, Lansing