

STATE OF MICHIGAN
DEPARTMENT
OF
NATURAL RESOURCES

LAND CORNER RECORD


LAKE COUNTY
T 19 N R 13 W

DESCRIPTION OF CORNER SW corner - Section 35

CORNER MONUMENT Found U.S.F.C. concrete monument and disk.

DATE MONUMENT PLACED AND WITNESSED 6-28-72

WITNESSES TO CORNER..... 10" Oak S 72 W 46.2

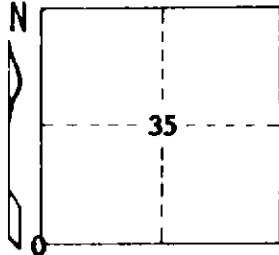

U.S.F.S. location
tag Due W 33.3'


Ctr. M-37 Due E 17'

AND

CIRCLE CORNER REGISTERED

DESCRIPTION IN DETAIL AS TO HOW CORNER WAS LOCATED AND IDENTIFIED OR RESTORED.

Recovered U.S.F.S. corner of record. The NW corner of Section 2, T18N - R13W, is 5.94' East.

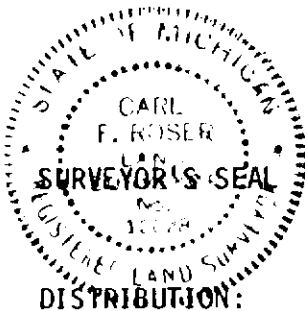

DISTRIBUTION:

SIGNED

Carl F. Rose

DATE 7-5-72

REGISTERED LAND SURVEYOR
12028

Forestry Division, Lansing