

STATE OF MICHIGAN
DEPARTMENT
OF
NATURAL RESOURCES


LAND CORNER RECORD

LAKE COUNTY
T 19 N R 13 W

DESCRIPTION OF CORNER North 1/4 corner - Section 35
CORNER MONUMENT Found 1" x 24" iron pin in ctr. N-S dirt road. Added DNR monument buried 6"
DATE MONUMENT PLACED AND WITNESSED 5-8-72

WITNESSES TO CORNER.....

W. Oak 15"	S 20 W	63.1'
SW Cor Cottage	N 60 W	93.9'
CL E-W dirt road	Due S	3'

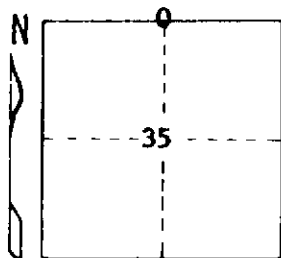


AND

CIRCLE CORNER REGISTERED

DESCRIPTION IN DETAIL AS TO HOW CORNER WAS LOCATED AND IDENTIFIED OR RESTORED.

Found recovered Brass corner of record.

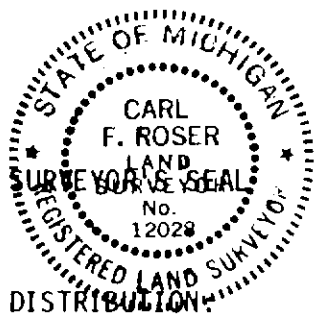

SIGNED

Carl F. Roser

DATE

5-15-72

REGISTERED LAND SURVEYOR

12028

DISTRIBUTION:

Forestry Division, Lansing