

STATE OF MICHIGAN
DEPARTMENT
OF
NATURAL RESOURCES

LAND CORNER RECORD


LAKE COUNTY
T 19 N R 13 W

DESCRIPTION OF CORNER North 1/16 corner on East line - Section 35

CORNER MONUMENT Set 1" x 36" pipe buried 8"

DATE MONUMENT PLACED AND WITNESSED 6-8-72

WITNESSES TO CORNER..... W. Oak 13" S 55 W 28.0'

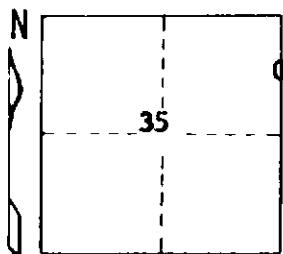

B. Oak 18" S 45 E 30.5'


ctr. N-S rd. Due E 1'

AND

CIRCLE CORNER REGISTERED

DESCRIPTION IN DETAIL AS TO HOW CORNER WAS LOCATED AND IDENTIFIED OR RESTORED.

Corner established per standard BLM instructions.

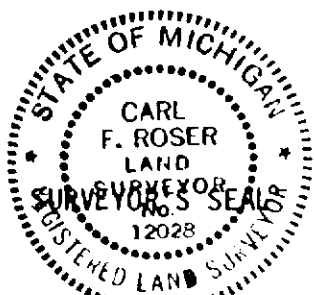

DISTRIBUTION:

SIGNED

Carl F. Roser
REGISTERED LAND SURVEYOR 12028

DATE

6-15-72

Forestry Division, Lansing