

STATE OF MICHIGAN
DEPARTMENT
OF
NATURAL RESOURCES

LAND CORNER RECORD


LAKE COUNTY
T 19 N R 13 W

DESCRIPTION OF CORNER East 1/16 on South line of Section 35

CORNER MONUMENT Set 1" x 36" pipe & cedar post with location tag

DATE MONUMENT PLACED AND WITNESSED 6-30-72

WITNESSES TO CORNER..... The East 1/16 corner on N line of Section 2

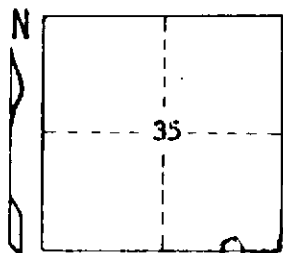

(T18N - R13W) is 1.5' East.


No Witnesses available

AND

CIRCLE CORNER REGISTERED

DESCRIPTION IN DETAIL AS TO HOW CORNER WAS LOCATED AND IDENTIFIED OR RESTORED.

Corner established by proportionate measurement between Section corner East and 1/4 corner West.

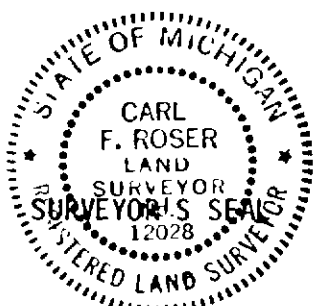

SIGNED

Carl F. Roser
REGISTERED LAND SURVEYOR

DATE

7-7-72

DISTRIBUTION:

Forestry Division, Lansing