LAND CORNER RECORDATION CERTIFICATE
Filing Requirement of Act 74, Mich. P.A. 1970

For corners in LAKE (County)

	Located In:	Corner Code ##
1. Public Land Survey	T 19N R 13W	I-9
	T ___ R ___	J-9
	T ___ R ___	
	T ___ R ___	
2. Property Controlling	S 26 T ___ R ___	1
in Section	S ___ T ___ R ___	
3. Miscellaneous	S ___ T ___ R ___	
Property in Sec.	S ___ T ___ R ___	

Register of Deeds Stamp & File Number

4. Lot No. _____ , Recorded Plat _____
5. Private Claims _____

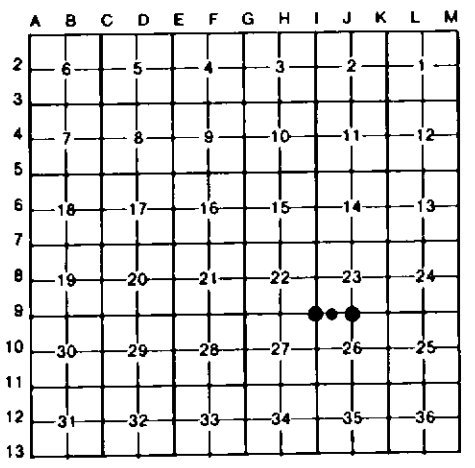

I, CARL F. ROSER, in a field survey on APRIL 1, 19 83, do hereby certify that under requirements of P.A. 74, Michigan P.A. of 1970, the corner points mentioned in lines 1 and 2 above were in conformance with regulations and rules therefore as required in the current manual of survey instructions of the United States Department of the Interior, Bureau of Land Management or by a decree of a Court of Law and/or that the corner points mentioned in lines 3, 4 and 5 above were in conformance with the rules of the Michigan Board of Land Surveyors or by a Decree of a Court of Law; established, re-established, monumented, re-monumented, recovered, found as expressed below:

NOTE: Not more than 4 corners, all in the same town and range, may be recorded on this certificate.

A. Description of original monument and accessories and/or subsequent restoration:

I-9

J-9

1

B. Description of corner evidence found and/or method applied in restoring or reestablishing corner:

I-9

FD USFS MON FOR NW COR S-26. FITS 3 FOREST SERVICE WITS & 1 G. BLASS WIT. BLASS SAYS "STONE FROM 1932 MSHD SURVEY REMOVED; REPLACED FROM MSHD 1932 WITS".

J-9

FD 3/4" PIPE FOR N 1/4 COR SEC 26. ESTAB BY BLASS IN 1957; M.O.L.

1

FD 1/2" IR W/RLS CAP FOR NE COR OF NW1/4 OF NW1/4 OF S-26.

C. Description of monument for corner and accessories established to perpetuate locating the position of the corner:

I-9

FD F.S. BRASS CAPPED CONC MON;BURIED ONE FT.

9"W OAK	S50°E	110.53
6" MAPLE	N55°E	91.35
X ON TOP OF 2.5'x 2'		
STONE	N40°W	125.7
CTR M-37	DUE W	15'
CTR DIRT RD E	DUE S	9'

J-9

FD 3/4" PIPE

* 14" B OAK	N40°E	52.3
* 18" B OAK	DUE S	26.6
* 14" B OAK	N20°W	62.6
CTR E-W DIRT RD	DUE S	2'
SET CED POST	DUE N	33'

* = G BLASS WITS, 1957

1

FD 1/2" IR W/RLS CAP

CTR E-W DIRT RD	DUE S	7'
6" W OAK	N40°E	26.6
12" B OAK	N25°W	48.1
FD 1/2" IR W/RLS CAP		
	DUE W	33.0
FD 1/2" IR W/RLS CAP		
	DUE S	33.0

STATE OF MICHIGAN
CARL F. ROSER
LAND SURVEYOR
No. 12028
REGISTERED LAND SURVEYOR

Signed by Carl F. Roser 01-26-88 Date _____

Surveyor's Michigan License No. 12028

FORM APPROVED BY MICHIGAN STATE BOARD OF LAND SURVEYORS, JAN. 28, 1971
REVISED MAY 14, 1975
REVISED JAN., 1983