LAND CORNER RECORDATION CERTIFICATE

Filing Requirement of Act 74, Mich. P.A. 1970

For corners in
Lake
(County)

		Located In:		Corner Code #/
1. Public Land Survey		T 19 N	R 13 W	M-9
		T	R	L-9
		T	R	K-9
		T	R	
2. Property Controlling	S 24	T	R	15
in Section	S	T	R	
3. Miscellaneous	S	T	R	
Property in Sec.	S	T	R	

Register of Deeds Stamp & File Number

4. Lot No. , Recorded Plat
5. Private Claims

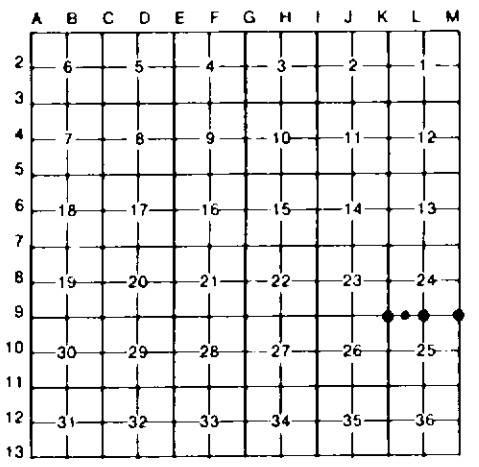

I, CARL F. ROSER, in a field survey on JUNE 14, 19 84, do hereby certify that under requirements of P.A. 74, Michigan P.A. of 1970, the corner points mentioned in lines 1 and 2 above were in conformance with regulations and rules therefore as required in the current manual of survey instructions of the United States Department of the Interior, Bureau of Land Management or by a decree of a Court of Law and/or that the corner points mentioned in lines 3, 4 and 5 above were in conformance with the rules of the Michigan Board of Land Surveyors or by a Decree of a Court of Law, established, re-established, monumented, re-monumented, recovered, found as expressed below.

NOTE: Not more than 4 corners, all in the same town and range, may be recorded on this certificate.

A. Description of original monument and accessories and/or subsequent restoration:

M-9
L-9
K-9
15

B. Description of corner evidence found and/or method applied in restoring or reestablishing corner:

M-9
COR IS PREVIOUS DEPT. COR OF RECORD, CFR 1973. DEPT MON WAS ADDED TO FD & ACCEPTED RLS G. BLASS COR OF RECORD IN 1972.

L-9
ACCEPTED FD 1/2" PIPE FOR N1/4 SEC 25. MON FITS 3 RLS PAT SALISBURY 1972 WITS, 3 WITS FROM RLS C. COLE RECORDS AND 2 RLS G. BLASS 1964 WITS.

K-9
ACCEPTED 3/4" PIPE FOR NW COR SEC 25. COR IS RLS G. BLASS 1954 COR OF RECORD.

15
ESTABILISHED SE COR, SW1/4, SW1/4, SEC 24 PER STD BLM INSTRUCTIONS.

STATE OF MICHIGAN
CARL F. ROSER
LAND SURVEYOR
No. 12028
REGISTERED LAND SURVEYOR

C. Description of monument for corner and accessories established to perpetuate locating the position of the corner:

M-9

FD D.N.R. MON.		
P.POLE	N 27°W	41.30'
22" B OAK	S 35°E	65.86'
17" B OAK	S 55°W	66.83'
SET CED POST		
W/LOC TAG	DUE N	33'
CTR SAND RD S	DUE W	4'
CTR E-W RD	DUE N	13'

L-9

FD 1/2"X 24" PIPE		
FD CONC MON	N01°06W	33.05'
P.POLE	S 60°W	20.93'
15" TRIPLE		
B OAK	N 72°E	72.70'
17" B OAK	N 50°W	49.25'
SET CED POST		
W/LOC TAG	DUE N	33'
CTR E-W GR RD	DUE N	10'

K-9

FD 3/4" IR. PIPE; RAISED		
W/5/8"X17" RE-ROD W/RLS CAP		
9" W OAK	S 35°W	49.50'
*10" W OAK	S 38°E	33.95'
*9" W OAK	S 5°E	26.28'
CTR LINE E-W		
GR. RD	DUE S	5'±
SET CED POST		
W/LOC TAG	DUE S	33'

* = G. BLASS WITS.

15

DROVE 5/8" X 34" RE-ROD		
W/RLS CAP		
16" B OAK	N 20°W	31.66'
12" B OAK		
TWIN	N 50°E	35.10'
FD CONC MON	N7°39W	33.78'
CTR LINE E-W		
GRAVEL RD	DUE N	3'±
SET CED POST		
W/LOC TAG	DUE N	33'

Signed by Carl F. Roser 3-16-88 Date

Surveyor's Michigan License No. 12028

FORM APPROVED BY MICHIGAN STATE BOARD OF LAND SURVEYORS, JAN. 28, 1971
REVISED MAY 14, 1975
REVISED JAN., 1983