LAND CORNER RECORDATION CERTIFICATE

Filing Requirement of Act 74, Mich. P.A. 1970

For corners in
LAKE
(County)

		Located In:	Corner Code
1. Public Land Survey		T 19 N R 13 W	L-10
		T ___ R ___	
		T ___ R ___	
		T ___ R ___	
2. Property Controlling	S 25	T ___ R ___	8, 9, 13
in Section	S ___	T ___ R ___	
3. Miscellaneous	S ___	T ___ R ___	
Property in Sec.	S ___	T ___ R ___	

Register of Deeds Stamp & File Number

4. Lot No. ___, Recorded Plat ___
5. Private Claims ___

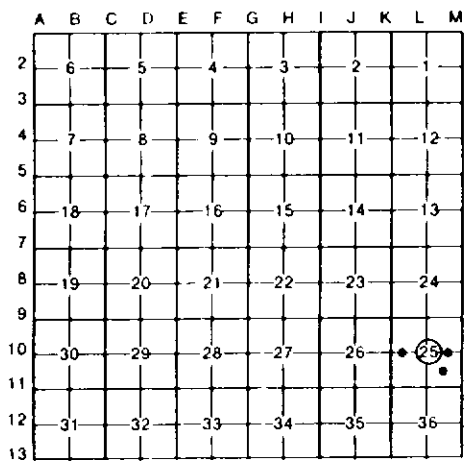

I, CARL F. ROSER, in a field survey on JUNE 12, 19 84, do hereby certify that under requirements of P.A. 74, Michigan P.A. of 1970, the corner points mentioned in lines 1 and 2 above were in conformance with regulations and rules therefore as required in the current manual of survey instructions of the United States Department of the Interior, Bureau of Land Management or by a decree of a Court of Law and/or that the corner points mentioned in lines 3, 4 and 5 above were in conformance with the rules of the Michigan Board of Land Surveyors or by a Decree of a Court of Law; established, re-established, monumented, re-monumented, recovered, found as expressed below:

NOTE: Not more than 4 corners, all in the same town and range, may be recorded on this certificate.

A. Description of original monument and accessories and/or subsequent restoration:

L-10	8	9	13
ESTABILISH CTR SEC. 25 AT INTERSECTING 1/4 LINES.	ACCEPTED FD T IRON FOR NW COR, E 1/2, SW 1/4 SEC. 25. FD T IRON HAS RLS G. BLASS I.D. TAG.	ESTABILISH NE COR, N 1/2, SE 1/4, SEC. 25 PER STD BLM INSTRUCTIONS.	ESTABILISH NW COR, SE 1/4, SE 1/4, SEC. 25 PER STD BLM INSTRUCTIONS.

B. Description of corner evidence found and/or method applied in restoring or reestablishing corner:

L-10	8	9	13
ESTABILISH CTR SEC. 25 AT INTERSECTING 1/4 LINES.	ACCEPTED FD T IRON FOR NW COR, E 1/2, SW 1/4 SEC. 25. FD T IRON HAS RLS G. BLASS I.D. TAG.	ESTABILISH NE COR, N 1/2, SE 1/4, SEC. 25 PER STD BLM INSTRUCTIONS.	ESTABILISH NW COR, SE 1/4, SE 1/4, SEC. 25 PER STD BLM INSTRUCTIONS.

C. Description of monument for corner and accessories established to perpetuate locating the position of the corner:

L-10			8			9			13		
DROVE 5/8"X34" RE-ROD W/RLS CAP; SET CED POST W/LOC TAG.			FD 3/4" T IRON W/RLS TAG; ADDED CED POST W/LOC TAG.			DROVE 5/8"X34" RE-ROD W/RLS CAP; SET CED POST W/LOC TAG.			DROVE 5/8"X34" RE-ROD W/RLS CAP; SET CED POST W/LOC TAG.		
8" B OAK	N 45°W	27.3'	14" B OAK	N 60°E	5.1'	6" W OAK	N 80°W	16.4'	14" OAK	N 25°W	6.6'
8" W OAK	S 80°E	12.4'	7" W OAK	S 30°W	9.0'	6" W OAK	N 20°E	14.1'	5" OAK	S 70°E	34.9'
8" W PINE	S 55°W	15.9'	12" B OAK	N 50°W	12.9'	16" B OAK	S 20°E	13.7'	4" MAPLE	S 20°W	13.1'
			CTR TRAIL	DUE S	50'						

Signed by Carl F. Roser 3-16-88 Date ___

Surveyor's Michigan License No. 12028

STATE OF MICHIGAN
CARL F. ROSER
LAND SURVEYOR
No. 12028
REGISTERED LAND SURVEYOR

FORM APPROVED BY MICHIGAN STATE BOARD OF LAND SURVEYORS, JAN 28, 1971
REVISED MAY 14, 1975
REVISED JAN., 1983