LAND CORNER RECORDATION CERTIFICATE

Filing Requirement of Act 74, Mich. P.A. 1970

For corners in
LAKE
(County)

		Located In:	Corner Code #1
1. Public Land Survey		T 19 N R 13 W	L-11
		T R	M-10
		T R	
		T R	
2. Property Controlling	S 25	T R	14
in Section	S	T R	15
3. Miscellaneous	S	T R	
Property in Sec.	S	T R	

Register of Deeds Stamp & File Number

4. Lot No. _____, Recorded Plat _____
5. Private Claims _____

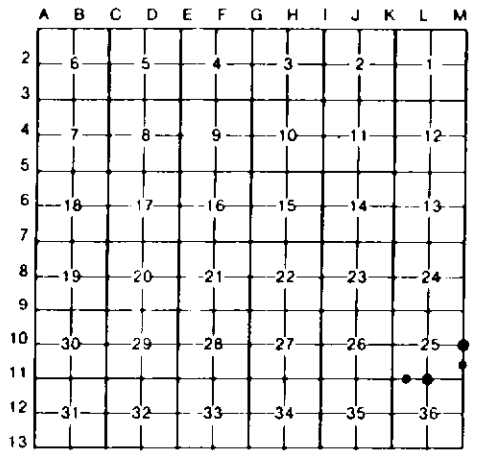

I, CARL F. ROSER, in a field survey on JUNE 11, 19 84, do hereby certify that under requirements of P.A. 74, Michigan P.A. of 1970, the corner points mentioned in lines 1 and 2 above were in conformance with regulations and rules therefore as required in the current manual of survey instructions of the United States Department of the Interior, Bureau of Land Management or by a decree of a Court of Law and/or that the corner points mentioned in lines 3, 4 and 5 above were in conformance with the rules of the Michigan Board of Land Surveyors or by a Decree of a Court of Law, established, re-established, monumented, re-monumented, recovered, found as expressed below:

NOTE: Not more than 4 corners, all in the same town and range, may be recorded on this certificate.

A. Description of original monument and accessories and/or subsequent restoration:

L-11

M-10

14

15

STATE OF MICHIGAN
CARL F. ROSER
LAND SURVEYOR
No. 12028
REGISTERED LAND SURVEYOR

B. Description of corner evidence found and/or method applied in restoring or reestablishing corner:

L-11
COR IS PREVIOUS DEPT. COR OF RECORD, CFR 1972. DEPT. MON WAS ADDED TO FD AND ACCEPTED RLS G. BLASS COR OF RECORD IN 1972.

M-10
COR IS PREVIOUS DEPT. COR OF RECORD, CFR 1972. DEPT. MON WAS ADDED TO FD AND ACCEPTED RLS G. BLASS COR OF RECORD IN 1972. FD 1/2" ROD 33' W, HAS RLS E. BENKERT I.D. CAP.

14
ESTABILISH NE COR, SE 1/4, SE 1/4, SEC 25, PER STD BLM INSTRUCTIONS. SET CED POST 33' W,BESIDE FD IRON W/RLS E. BENKERT I.D. CAP.

15
COR IS PREVIOUS DEPT. COR OF RECORD, CFR 1972. THE SW COR, E1/2, SW1/4 WAS ESTABILISHED PER STD BLM INSTRUCTIONS.

C. Description of monument for corner and accessories established to perpetuate locating the position of the corner:

L-11

FD D.N.R. MON.		
* 13" B OAK	N 34°E	48.8'
* 12" B OAK	N 73°W	35.5'
* 12" B. OAK	S 20°E	59.1'
CTR OF E-W RD	DUE S	10'
SET CED POST		
W/LOC TAG	DUE S	33'

* EQUALS RLS G. BLASS WITS.

M-10

FD D.N.R MON.		
P.POLE	S 35°W	44.29'
15" B OAK	S 50°W	78.98'
FD 1/2" RE-		
ROD	DUE N	33.00'
21" B OAK	S 70°E	25.32'
CTR N-S RD	DUE E	2'
CED POST	DUE E	33'

14

DROVE 5/8"X 34" RE-ROD W/CAP		
P.POLE	N 35°W	42.00'
12" W OAK	N 85°E	41.35'
P.POLE	S 20°E	70.58'
SET CED POST		
W/LOC TAG	DUE W	33.0'
CTR N-S RD	DUE E	5'
FD 3/4 SMOOTH		
IRON ROD	DUE E	33.0'
FD R.R. SPK	S87°27'E	2.21'

15

FD 1" PIPE		
8" W OAK	N 25°W	70.3'
17" B OAK		
IN CLUMP 2	N 35°E	37.3'
7" W OAK IN		
CLUMP 2	S 60°W	39.5'
SET CED POST		
W/LOC TAG	DUE N	33'
CTR E-W RD	DUE N	2'

Signed by Carl F. Roser 3-18-88 Date _____

Surveyor's Michigan License No. 12028

FORM APPROVED BY MICHIGAN STATE BOARD OF LAND SURVEYORS, JAN. 28, 1971
REVISED MAY 14, 1975
REVISED JAN., 1983