

LAND CORNER RECORDATION CERTIFICATE
Filing Requirement of Act 74, Mich. P.A. 1970

For corners in
LAKE

_____ (County)	Located In:	Corner Code ##
1. Public Land Survey	T <u>19 N</u> R <u>13 W</u>	_____
	T _____ R _____	_____
	T _____ R _____	_____
	T _____ R _____	_____
2. Property Controlling in Section	S <u>35</u> T _____ R _____	<u>4, 5, 6</u>
	S _____ T _____ R _____	_____
3. Miscellaneous Property in Sec.	S <u>35</u> T _____ R _____	<u>+ 652.4' 6</u> <u>DF J-11</u>
	S _____ T _____ R _____	_____

Register of Deeds Stamp & File Number

4. Lot No. _____, Recorded Plat _____
 5. Private Claims _____

I, **CARL F. ROSER**, in a field survey on **JUNE 6**, 19 **84**, do hereby certify that under requirements of P.A. 74, Michigan P.A. of 1970, the corner points mentioned in lines 1 and 2 above were in conformance with regulations and rules therefore as required in the current manual of survey instructions of the United States Department of the Interior, Bureau of Land Management or by a decree of a Court of Law and/or that the corner points mentioned in lines 3, 4 and 5 above were in conformance with the rules of the Michigan Board of Land Surveyors or by a Decree of a Court of Law, established, re-established, monumented, re-monumented, recovered, found as expressed below:

A	B	C	D	E	F	G	H	I	J	K	L	M
2	6	5	4	3	2	1						
3												
4	7	8	9	10	11	12						
5												
6	18	17	16	15	14	13						
7												
8	19	20	21	22	23	24						
9												
10	30	29	28	27	26	25						
11												
12	31	32	33	34	35	36						
13												


NOTE: Not more than 4 corners, all in the same town and range, may be recorded on this certificate.

A. Description of original monument and accessories and/or subsequent restoration:

4	5	6	4
ESTABLISH NW COR, SE 1/4, NW 1/4, SEC 35, PER STD BLM INSTRUCTIONS.	ESTABLISH NE COR, SE 1/4, NW 1/4, SEC 35 PER STD BLM INSTRUCTIONS.	ESTABLISH NW COR, SE 1/4, NE 1/4, SEC 35 PER STD BLM INSTRUCTIONS.	ESTABLISH NW COR, S 1/2, NW 1/4, NE 1/4, SEC 35 PER STD BLM INSTRUCTIONS.

C. Description of monument for corner and accessories established to perpetuate locating the position of the corner.

4	5	6	4
DROVE 5/8"X34° RE-ROD W/RLS CAP; SET CED POST W/LOC TAG.	DROVE 5/8"X34° RE-ROD W/RLS CAP; SET CED POST W/LOC TAG.	DROVE 5/8"X 34° RE-ROD W/RLS CAP; SET CED POST W/LOC TAG.	DROVE 5/8"X 134° RE-ROD W/RLS CAP; SET CED POST W/LOC TAG.
5° B OAK N 40°W 15.5'	5° W OAK N 10°W 13.2'	8° B OAK N 10°W 13.9'	8° B OAK N 55°W 6.7'
8° W OAK S 80°E 18.5'	6° B OAK N 85°E 21.5'	6° W OAK N 75°E 13.8'	6° W OAK S 35°E 18.7'
4° B OAK S 15°E 6.1'	8° MAPLE S 75°W 10.5'	5° B OAK S 15°E 14.1'	6° W OAK S 30°W 14.6'
FB 3/4" PIPE W/COUPLING S33°07'E 29.32'			

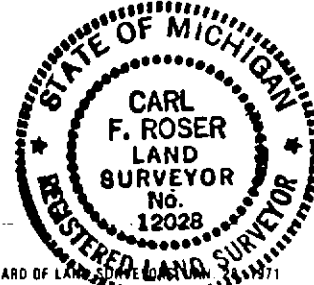

Signed by Carl F. Roser 3-18-88 Date _____
 Surveyor's Michigan License No. 12028