LAND CORNER RECORDATION CERTIFICATE

Filing Requirement of Act 74, Mich. P.A. 1970

For corners in

LAKE
(County)

Located In: Corner Code 77

1. Public Land Survey		T 19N	R 13W	I-5, J-5
		T	R	
		T	R	
		T	R	
2. Property Controlling	S 11	T	R	15, 16
in Section	S	T	R	
3. Miscellaneous	S	T	R	
Property in Sec.	S	T	R	

Register of Deeds Stamp & File Number

4. Lot No. ____ , Recorded Plat ____
5. Private Claims ____

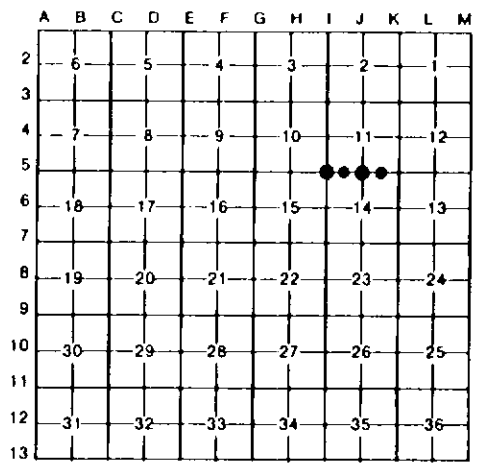

16

I, CARL T. KIISKILA, in a field survey on MAY 19, 19 94, do hereby certify that under requirements of P.A. 74, Michigan P.A. of 1970, the corner points mentioned in lines 1 and 2 above were in conformance with regulations and rules therefore as required in the current manual of survey instructions of the United States Department of the Interior, Bureau of Land Management or by a decree of a Court of Law and/or that the corner points mentioned in lines 3, 4 and 5 above were in conformance with the rules of the Michigan Board of Land Surveyors or by a Decree of a Court of Law; established, re-established, monumented, re-monumented, recovered, found as expressed below:

NOTE: Not more than 4 corners, all in the same town and range, may be recorded on this certificate.

A. Description of original monument and accessories and/or subsequent restoration:

I-5 J-5 15

B. Description of corner evidence found and/or method applied in restoring or reestablishing corner:

I-5	J-5	15	16
FD USFS MON, AS SET BY R.GRIFFEN IN 1972 IN PLACE OF FD 5/8" BOAT SPIKE, IN MON BOX. G.BLASS SET 5/8" BOAT SPIKE IN 1956 "FROM WITNESS OF MSHD". COR IS IN LINE W/CTR OF 4 MILE (B.TOP) RD TO WEST. CTR OF M-37 IS 8' EAST.	REESTAB'D S 1/4 COR S-11 MIDWAY & ON LINE BETN FD SEC CORS 1/2 MILE TO E & W. THIS POSITION FITS PREVIOUS SURVEYS IN SEC 11 & 14 BY G.BLASS RLS #5489, K.ROSS PS #17634 & C.COLE PS#17615. FD 1" PIPE AS SET BY K.ROSS IN ERROR, N66 42'E 21.41'. CTR OF TRAIL N'LY & SE'LY IS 519+ 4' EAST.	FD C.COLE, PS#17615, IRON FOR THE SW COR OF SE 1/4 OF SW 1/4 SEC 11. COR FITS C.COLE CERT OF SURVEY DATED 4/18/88, FILE #4977-88.	SET 1" PIPE FOR SW COR OF SE 1/4 OF SE 1/4 S-11 PER STANDARD BLM INSTRUCTIONS. FD OLD 1" PIPE, LEANING S'LY 1/2' NORTH OF OUR CORNER. CTR OF MOTOR SPORTS TRAIL IN CURVE (COURSE S & E) IS S35°E 12'.

C. Description of monument for corner and accessories established to perpetuate locating the position of the corner:

I-5	J-5	15	16
FD USFS BRASS CAP CONC MON UNDER W EDGE MON BOX.	SET DNR MON & CED POST.	FD 1/2" REROD W/RLS CAP. ADDED CED POST W/LOC TAG.	DROVE 1" X 60" GALV PIPE W/LS CAP. SET CED POST W/LOC TAG.
	10" MAPLE N30°W 15.1'		
#POWER POLE N50°W 64.65'	5" W PINE N10°E 24.9'	9" W PINE N50°W 47.2'	13" HEMLOCK S25°E 33.4'
FACE 3" R PINE N55°E 87.0'	5" W PINE N75°E 14.0'	2" MAPLE N50°E 9.2'	11" CEDAR S10°E 45.5'
#POWER POLE S40°E 69.90'	6" W PINE S75°E 33.9'	10" MAPLE S50°E 13.5'	23" W PINE S15°W 69.8'
NE COR 1 1/2'X3'X4'H STEEL		4" OAK S60°W 5.0'	4" ASH S85°W 19.6'
UTIL BOX #9010 S30°W 89.04'			SW COR WOOD BRIDGE DECK OVER LITTTLE MANISTEE RIVER S85°E 65.4'
#WIT BY OTHERS.			

Signed by Carl T. Kiiskila Date 5-16-97

Surveyor's Michigan License No. 33981

FORM APPROVED BY MICHIGAN STATE BOARD OF LAND SURVEYORS, JAN. 28, 1971
REVISED MAY 14, 1975
REVISED JAN., 1983