LAND CORNER RECORDATION CERTIFICATE

Filing Requirement of Act 74, Mich. P.A. 1970

For corners in
LAKE
(County)

Located In: Corner Code 11

1. Public Land Survey — T 19N R 13W — K-4, K-5
   T ___ R ___
   T ___ R ___
   T ___ R ___
2. Property Controlling — S ___ T ___ R ___
   in Section — S ___ T ___ R ___
3. Miscellaneous — S T R
   Property in Sec. — S ___ T ___ R ___

Register of Deeds Stamp & File Number

4. Lot No. ___, Recorded Plat ___
5. Private Claims ___

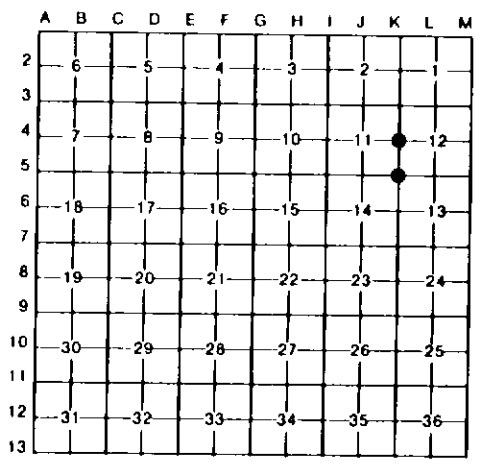

I, CARL T. KIISKILA, in a field survey on MARCH, 6, 19 96, do hereby certify that under requirements of P.A. 74, Michigan P.A. of 1970, the corner points mentioned in lines 1 and 2 above were in conformance with regulations and rules therefore as required in the current manual of survey instructions of the United States Department of the Interior, Bureau of Land Management or by a decree of a Court of Law and/or that the corner points mentioned in lines 3, 4 and 5 above were in conformance with the rules of the Michigan Board of Land Surveyors or by a Decree of a Court of Law; established, re-established, monumented, re-monumented, recovered, found as expressed below:

NOTE: Not more than 4 corners, all in the same town and range, may be recorded on this certificate.

A. Description of original monument and accessories and/or subsequent restoration:

K-4

K-5

B. Description of corner evidence found and/or method applied in restoring or reestablishing corner:

K-4

FD CONC MON W/BRASS CAP STAMPED "GEORGE BLASS RLS 5489" FOR E1/4 COR. SEC. 11. G.BLASS 1941 COR RECORD SAYS "PLACED CORNER AT THE MIDPOINT OF LINE BETWEEN SEC CORNERS". CTR OF N-S SAND RD IS 11' EAST.

K-5

FD DEPT. MON AS SET IN 1969 FOR SE COR S-11. DEPT. MON WAS SET IN PLACE OF FOUND 5/8" ROD SET BY G.BLASS IN 1941, FROM OLD WIT'S.

C. Description of monument for corner and accessories established to perpetuate locating the position of the corner:

K-4

FD BRASS CAPPED CONC. MON.		
10" B.CHERRY	N45°W	31.4'
3" OAK	N20°W	51.6'
8" OAK	EAST	59.5'
17" B.CHERRY	S70°W	30.4'
FD. CEDAR POST WITH DNR LOCATION TAG	WEST	33'

K-5

DNR MON.		
#19" OAK	N45°W	81.76'
#14" MAPLE	N60°E	73.16'
5" W.PINE	S35°E	80.65'
#9" OAK	S30°W	58.94'
FD CEDAR POST W/DNR LOCATION TAG	WEST	33'

#= 1969 PS, C.F.ROSER WIT.

STATE OF MICHIGAN
CARL KIISKILA
LAND SURVEYOR
No. 33981
LICENSED LAND SURVEYOR

Signed by Carl T. Kiiskila Date 5-16-97

Surveyor's Michigan License No. 33981

FORM APPROVED BY MICHIGAN STATE BOARD OF LAND SURVEYORS, JAN. 28, 1971
REVISED MAY 14, 1975
REVISED JAN., 1983