

JAN 25 2001 LAND CORNER RECORDATION CERTIFICATE

FILING REQUIREMENT OF ACT 74, Mich. P.A. 1970

SECTION

For corners in Lake _____	Located in:	Corner Code#
1. Public Land Survey	T 19 N	R 13 W C-10
	T	R
	T	R
	T	R
2. Property Controlling in Section	S T	R
	S T	R
3. Miscellaneous Property in Sec.	S T	R
	S T	R
4. Lot No. _____ Recorded Plat		
5. Private Claims _____		

RECORDED
LAKE COUNTY MI
LIBER 004 PAGE 0278

DEC 8 11 22 AM '00

Shelley Myers
REGISTER OF DEEDS

Register of Deeds Stamp & File Number

	A	B	C	D	E	F	G	H	I	J	K	L	M
1													
2	6	5	4	3	2	1							
3													
4	7	8	9	10	11	12							
5													
6	18	17	16	15	14	13							
7													
8	19	20	21	22	23	24							
9													
10	30	29	28	27	26	25							
11													
12	31	32	33	34	35	36							
13													

I, Robert L. Wetherell, in a field survey on February 23, 2000, do hereby certify that under requirements of P.A. 74, Michigan P.A. of 1970, the corner points mentioned in lines 1 and 2 above were in conformance with regulations and rules therefore as required in the current manual of survey instructions of the United States Department of the Interior, Bureau of Land Management or by decree of a Court of Law and/or that the corner points mentioned in lines 3, 4, and 5 above were in conformance with the rules of the Michigan Board of Land Surveyors or by a Decree Of a Court of Law; established, re-established, monumented, re-monumented, recovered, found as expressed below:

C-10 - 1/4 Corner common to Sections 29 & 30, T19N, R13W

A. Description of original monument and accessories and/or subsequent restoration:

1838 - S. Sibley, G.L.O.

- #1 - 10" Pine S64°W 60 Links
- #2 - 9" Pine S26°W 89 Links

1989 - C. Cole, LS 17615

- Set corner by single proportionate measurement.
- 2714.47 feet each way.
- #3 - 7" W. Oak N76°E 43.29'
- #4 - 3" B. Oak N69°W 19.18'
- #5 - 4" B. Oak S51°W 30.73'

B. Description of corner evidence found and/or method applied in restoring of reestablishing corner:


I found a 1/2" rod with cap marked LS 17615 (Cole). The corner is 59 feet more or less West of the centerline of two-track road.

C. Description of monument for corner and accessories established to perpetuate locating the position of the corner:

I replaced the 1/2" rebar with a 3/4" x 24" rebar with a Lake County Remon Cap, and is accepted as a careful and faithful reestablishment of the position of the original corner.

- 5" B. Oak S52°W 30.71' (60d spike in S. side) #5
- 4" B. Oak N69°W 19.26' (60d spike in N. side) #4
- 8" W. Oak N79°E 43.28' (60d spike in S. side) #3
- 7" W. Oak S48°E 46.89' (60d side in S. side)

ATTESTED BY THE LAKE CO. DEED REVIEW GROUP
IN ACCORDANCE WITH P.A. 345
CHAIRMAN R L W
DATE 12-5-2000

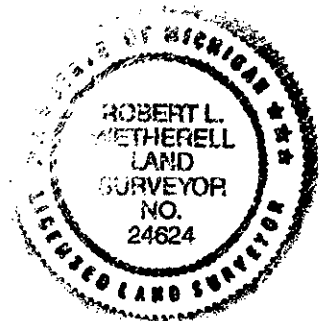

Signed by Robert L. Wetherell

Date December 6, 2000

Surveyor's Michigan License No. 24624