

REMONUMENTATION

NOV 21 1997

COMMISSION

LAND CORNER RECORDATION CERTIFICATE  
Filing Requirement of Act 74, Mich. P.A. 1970

LIBER 004 PAGE 0022

RECORDED  
LAKE COUNTY, MI.

SEP 12 10 29 AM '97

For corners in  
Lake \_\_\_\_\_

Lake (County)	Located in:	Corner Code #	
		19N	13W
1. Public Land Survey	T	R	E-5
	T	R	
	T	R	
	T	R	
2. Property Controlling in Section	S	T	R
	S	T	R
3. Miscellaneous Property in Sec.	S	T	R
	S	T	R

REGISTER OF DEEDS


Register of Deeds Stamp & File Number

- 4. Lot No. \_\_\_\_\_, Recorded Plat \_\_\_\_\_
- 5. Private Claims \_\_\_\_\_

Robert L. Wetherell April 3, 97

I, \_\_\_\_\_, in a field survey on \_\_\_\_\_, 19 \_\_\_\_\_, do hereby certify that under requirements of P.A. 74, Michigan P.A. of 1970, the corner points mentioned in lines 1 and 2 above were in conformance with regulations and rules therefore as required in the current manual of survey instructions of the United States Department of the Interior, Bureau of Land Management or by a decree of a Court of Law and/or that the corner points mentioned in lines 3, 4 and 5 above were in conformance with the rules of the Michigan Board of Land Surveyors or by a Decree of a Court of Law; established, re-established, monumented, re-monumented, recovered, found as expressed below:

NOTE: Not more than 4 corners, all in the same town and range, may be recorded on this certificate.

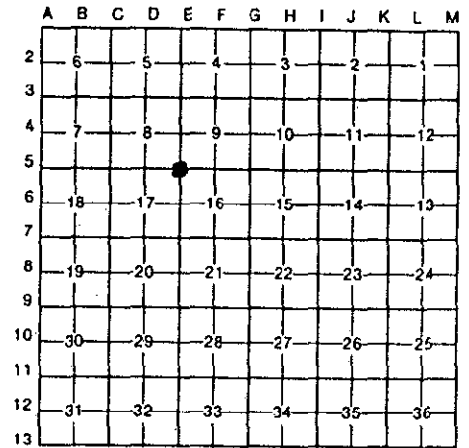

A. Description of original monument and accessories and/or subsequent restoration:

- E-5 - Corner common to Sections 8, 9, 16 & 17, T19N, R13W, Peacock Twp., Lake Co., Mi.
  - 1838 - S. Sibley - G.L.O.
  - #1 - 10" Pine N5°W 23 Links
  - #2 - 8" Pine S17°E 19 Links
  - 1908 - Theo. Norlin
  - Surveyed plat of "Peacock"
  - #3 - E.1/4 Cor. Sec. 17 - South 2630.5'
  - #4 - N.1/4 Cor. Sec. 17 - West 2648'
  - 1927 - George Johnson - County Surveyor
  - #5 - 14" B. Oak N65°15'E 49.5'
  - #6 - 8" B. Oak S44°45'W 60.5'
  - 1929 - George Johnson - County Surveyor
  - Surveyed plat of "Supervisors plat of Peacock"
  - #3 - E.1/4 Cor. Sec. 17 - South 2633'
  - #4 - N.1/4 Cor. Sec. 17 - West 2647'

B. Description of corner evidence found and/or method applied in restoring or reestablishing corner: (SEE OVER FOR CONTINUATION OF "A")


E-5 - Corner common to Sections 8, 9, 16 & 17, T19N, R13W, Peacock Twp., Lake Co., Mi.

I found a 5" Concrete Monument in centerline of East and West blacktop road and in centerline of road to South. The centerline of road to North is 3 feet West. I found a square concrete monument South 32.93 feet as reported on the "Supervisors Plat of Peacock". Condition of accessories are as follows: #1 - Gone, #2 Gone, #3 2631.8' (Ross 1974), #4 2648.5' (measured), #5 Gone, #6 Found stump, #7 Gone, #8 Found in poor condition, #9 Found in poor condition, #10 Found in good condition, #11 Gone, #12 Found in good condition (Jackpine), #13 Found in good condition.

RATIFIED BY THE LAKE CO. PEER REVIEW GROUP  
IN ACCORDANCE WITH P.A. 345  
CHAIRMAN R.L.W.  
DATE 8-27-97

C. Description of monument for corner and accessories established to perpetuate locating the position of the corner:

- E-5 - Corner common to Sections 8, 9, 16 & 17, T19N, R13W, Peacock Twp., Lake Co., Mi.
  - I accepted the Concrete Monument as a substantial marker for the corner and is accepted as a careful and faithful re-establishment of the position of the original corner.
  - P. Pole S19°E 56.89' (P.K. nail in W. side)
  - Sq. Concrete Monument S05°W 32.93'
  - 24" B. Oak S47°W 52.84' (60d spike in S.E. side) #9
  - 10" J. Pine N47°W 88.79' (dock spike in N.E. side) #12
  - 14" Tw. B. Oak N15°W 105.24' (60d spike in S.W. side)

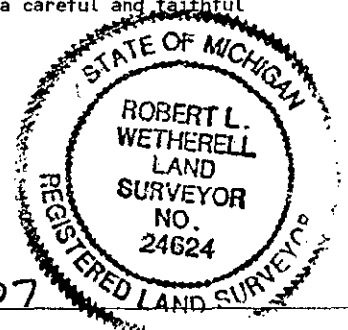

Signed by Robert L. Wetherell Date 8-27-97

Surveyor's Michigan License No. 24624

0004 - 22A

CONTINUATION OF "A" - DESCRIPTION OF ORIGINAL MONUMENT AND ACCESSORIES AND/OR SUBSEQUENT RESTORATION:

Undated County Surveyor's Book

1-1/4" Pipe

#7 - 13" B. Oak N65°E 49.0'

1941 - George Blass, LS 5489

Found Iron Bolt & Wood Stake

#8 - 16" B. Oak N55°E 75.00'

#9 - 16" B. Oak S40°W 52.60'

#6 - 14" B. Oak S43°W 60.60'

1972 - Robert A. Griffin, LS 13584

L.C.R.C. - Liber 02, Page 71

Found railroad link pin (replaced with 5" Concrete Monument)

#10 - P. Pole N10°E 152.87'

#11 - P. Pole S13°E 103.53'

#12 - 3" R. Pine N52°W 88.58'

#13 - 7' Post N45°W 46.65'

1974 - Kenneth Ross, LS 17634

Same accessories as Griffin