

**SURVEY &
REMONUMENTATION**

JAN 12 1996

COMMISSION

**LAKE COUNTY REMONUMENTATION
LAND CORNER RECORDATION CERTIFICATE**
Filing Requirement of Act 74, Mich. P.A. 1970

LIBER 003 PAGE 0295

For corners in

Lake (County)	Located In:		Corner Code #?
	19N	13W	
1. Public Land Survey	T _____	R _____	G-9
	T _____	R _____	
	T _____	R _____	
	T _____	R _____	
2. Property Controlling in Section	S _____	T _____ R _____	
	S _____	T _____ R _____	
3. Miscellaneous Property in Sec.	S _____	T _____ R _____	
	S _____	T _____ R _____	

REGISTER OF DEEDS
 JUN 9 3 51 PM '95
 LAKE COUNTY, MI.
 RECORDED

Register of Deeds Stamp & File Number

I, Robert L. Wetherell, January 7, 1995

do hereby certify that under requirements of P.A. 74, Michigan P.A. of 1970, the corner points mentioned in lines 1 and 2 above were in conformance with regulations and rules therefor as required in the current manual of survey instructions of the United States Department of the Interior, Bureau of Land Management or by a decree of a Court of Law and/or that the corner points mentioned in lines 3, 4 and 5 above were in conformance with the rules of the Michigan Board of Land Surveyors or by a Decree of a Court of Law; established, re-established, monumented, re-monumented, recovered, found as expressed below:

NOTE: Not more than 4 corners, all in the same town and range, may be recorded on this certificate.

	A	B	C	D	E	F	G	H	I	J	K	L	M
2	6	5	4	3	2	1							
3													
4	7	8	9	10	11	12							
5													
6	18	17	16	15	14	13							
7													
8	19	20	21	22	23	24							
9													
10	30	29	28	27	26	25							
11													
12	31	32	33	34	35	36							
13													

A. Description of original monument and accessories and/or subsequent restoration:


G-9 - Corner common to Sections 21, 22, 27 & 28, T19N, R13W, Peacock Twp., Lake Co., Mi.

- | | | |
|---|--|---|
| <p><u>1838 - S. Sibley, G.L.O.</u>
 #1 - 25" Pine S15°W 118 Links
 #2 - 24" Pine N36°E 87 Links</p> | <p><u>1913 - George Johnson, Co. Surveyor</u>
 Found both U.S. Witness stumps.
 Called for 3/4" iron
 #3 - 10" W. Oak N87°E 55'
 #4 - 16" W. Oak N46°E 93.8'</p> | <p><u>1953 - George Blass, LS 5489</u>
 Found 3/4" Bolt with nut - 3' long
 24" W. Oak N46°E 93.00' (O.B.T. #4)
 #5 - 12" Tw. W. Oak S42°E 35.50'
 #6 - 16" W. Oak S86°W 38.30'
 (Above were taken to face of tree)</p> |
|---|--|---|

B. Description of corner evidence found and/or method applied in restoring or reestablishing corner:

G-9 - Corner common to Sections 21, 22, 27 & 28, T19N, R13W, Peacock Twp., Lake Co., Mi.

I found a 3/4" Bolt, 3 feet long approximately 130 feet West of centerline of Old Railroad Grade. I recovered both of Surveyor Johnson's accessories and the remains of one U.S. witness stump (No. 2). I also recovered all of surveyor Blass accessories. Condition of accessories are as follows: #1 Gone, #2 Found remains, #3 Found in good condition, #4 Found stump #5 Found in good condition, #6 Found in good condition.

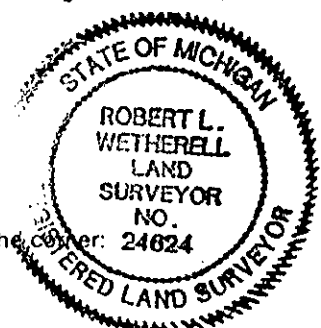

C. Description of monument for corner and accessories established to perpetuate locating the position of the corner:

G-9 - Corner common to Sections 21, 22, 27 & 28, T19N, R13W, Peacock Twp., Lake Co., Mi.

I place a Lake County Brass Cap on top of the found 3/4" bolt, and is accepted as a careful and faithful perpetuation of the original corner.

- 14" Tw. W. Oak S36°E 35.83' (60d spike in S.W. side) O.B.T. #5
- 18" W. Oak S88°E 56.73' (60d spike in N. side) O.B.T. #3
- 18" W. Oak S89°W 38.95' (60d spike in S. side) O.B.T. #6
- 15" B. Oak N02°W 28.58' (60d spike in E. side)
- 7" R. Pine N51°E 8.63' (60d spike in S.E. side)

RATIFIED BY THE LAKE CO. PEER REVIEW GROUP
 IN ACCORDANCE WITH P.A. 345
 CHAIRMAN A. Y. W.
 DATE 5.22.95

Signed by Robert L. Wetherell Date May 29, 1995
 Surveyor's Michigan License No. 24624