

COMPAASSED

LIBER 003 PAGE 0396

LAND CORNER RECORDATION CERTIFICATE
Filing Requirement of Act 74, Mich. P.A. 1970

For corners in

Table with columns: Lake (County), Located In: (19N, 13W), Corner Code # (L-5). Rows include Public Land Survey, Property Controlling in Section, and Miscellaneous Property in Sec.

RECORDED LAKE COUNTY, MI.
REGISTER OF DEEDS
Nov 14 11 26 AM '98

Register of Deeds Stamp & File Number

- 4. Lot No. , Recorded Plat
5. Private Claims

Grid table with columns A-L and rows 2-13. A dot is marked in row 5, column K.

I, Robert L. Wetherell, in a field survey on March 1, 1996, do hereby certify that under requirements of P.A. 74, Michigan P.A. of 1970, the corner points mentioned in lines 1 and 2 above were in conformance with regulations and rules therefore as required in the current manual of survey instructions of the United States Department of the Interior, Bureau of Land Management or by a decree of a Court of Law and/or that the corner points mentioned in lines 3, 4 and 5 above were in conformance with the rules of the Michigan Board of Land Surveyors or by a Decree of a Court of Law; established, re-established, monumented, re-monumented, recovered, found as expressed below:

NOTE: Not more than 4 corners, all in the same town and range, may be recorded on this certificate.

A. Description of original monument and accessories and/or subsequent restoration:

L-5 - Section corner common to Sections 12 and 13, T19N, R13W, Peacock Twp., Lake Co., Mi.

1838 - Sibley, G.L.O.
#1-12" Pine N78°W 15 Links
#2 - 16" Pine S32°E 27 Lins

1941 - George Blass, LS 5489
Computed position by single proportionate method. Did not set corner.

1968 - Carl Roser, LS 12028
Computed position according to to Blass in 1941. Did not set corner


(SEE OVER FOR CONTINUATION OF "A")

B. Description of corner evidence found and/or method applied in restoring or reestablishing corner:

L-5 - Section corner common to Sections 12 and 13, T19N, R13W, Peacock Twp., Lake Co., Mi.

I found the D.N.R. monument and accessories No. 3 thru No. 9 all in good condition. Accessories No. 1 and No. 2 were gone.

RATIFIED BY THE LAKE CO. PEER REVIEW GROUP
IN ACCORDANCE WITH P.A. 345
CHAIRMAN R.S.W.
DATE 11-12-96

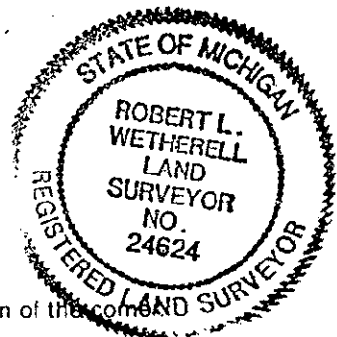

C. Description of monument for corner and accessories established to perpetuate locating the position of the corner:

L-5 - Section corner common to Sections 12 and 13, T19N, R13W, Peacock Twp., Lake Co., Mi.

I accepted the D.N.R. Monument as a substantial monument for the corner, and is accepted as a careful and faithful re-establishment of the position of the original corner.

- 14" Maple N42°E 86.68' (60d spike in N.W. side) #9
10" & 11" Tw. Maple S10°W 64.11' (60d spike in E. side) #8
12" x 18" Tw. B. Oak S38°E 26.00' (60d spike in E. side) #5
14" Maple N61°W 45.09' (60d spike in N.E. side) #3

Signed by Robert L. Wetherell Date 11-13-1996

Surveyor's Michigan License No. 24624

CONTINUATION OF "A" - DESCRIPTION OF ORIGINAL MONUMENT AND ACCESSORIES AND/OR SUBSEQUENT RESTORATION:1970 - George Blass, LS 5489

Set corner by single proportionate method. 3/4" x 20" Pipe (white making the plat of "Wilderness Acres")
 #3 - 10 Maple N58°W 44.95'
 #4 - 12" J. Pine S44°W 65.03'
 #5 - 10" B. Oak S37°E 25.65'

1982 - Carl Roser, LS 12028

L.C.R.C. Recorded in Liber 2, Page 410.
 Found Pipe - Added D.N.R. Monument & Post
 #6 - Fd. Conc. Mon. N85°47'W 136.9'
 #7 - Fd. Conc. Mon. S85°47'E 120.0'
 #3 - 13" Maple N55°W 45.04'
 #4 - 13" J. Pine S45°W 64.82'
 #5 - 12" & 19" B. Oak S35°E 26.22'

1992 - R.L. Wetherell, LS 24624

Found D.N.R. Monument
 #3 - 14" Maple N61°W 45.09'
 #5 - Tw. B. Oak S38°E 26.00'
 #8 - Tw. Maple S10°W 64.11'
 #9 - 14" Maple N42°E 86.68'