

MAY 16 1997

LAND CORNER RECORDATION CERTIFICATE  
Filing Requirement of Act 74, Mich. P.A. 1970


LIBER 003 PAGE 0398

For corners in MISSION

Lake (County)	Located In:	Corner Code --#
1. Public Land Survey	19N 13W	M-5 ✓
	T 19N R 12W	A-5
	T R	
	T R	
	T R	
2. Property Controlling in Section	S T R	
	S T R	
3. Miscellaneous Property in Sec.	S T R	
	S T R	

REGISTERED  
LAKE COUNTY, MI.  
NOV 14 11 26 AM '96  
REGISTER OF DEEDS  
Register of Deeds Stamp & File Number

4. Lot No. \_\_\_\_\_, Recorded Plat \_\_\_\_\_  
5. Private Claims \_\_\_\_\_

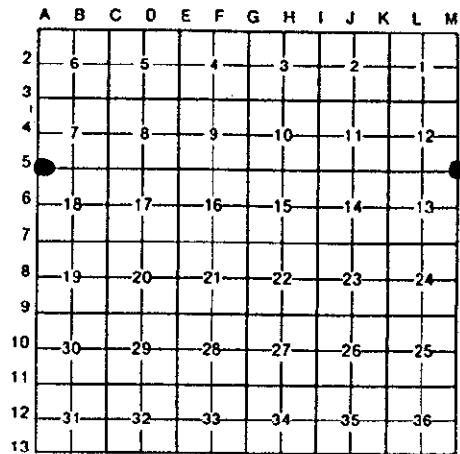

I, Robert L. Wetherell, in a field survey on March 1, 1996, do hereby certify that under requirements of P.A. 74, Michigan P.A. of 1970, the corner points mentioned in lines 1 and 2 above were in conformance with regulations and rules therefore as required in the current manual of survey instructions of the United States Department of the Interior, Bureau of Land Management or by a decree of a Court of Law and/or that the corner points mentioned in lines 3, 4 and 5 above were in conformance with the rules of the Michigan Board of Land Surveyors or by a Decree of a Court of Law; established, re-established, monumented, re-monumented, recovered, found as expressed below:

NOTE: Not more than 4 corners, all in the same town and range, may be recorded on this certificate.

A. Description of original monument and accessories and/or subsequent restoration:  
M-5 & A-5 - Section corner common to Sections 12 & 13, T19N, R13W, AND Sections 7 and 18, T19N, R12W, Lake Co., Mi.

- |                                 |                                     |   |
|---------------------------------|-------------------------------------|---|
| <u>1838 - S. Sibley, G.L.O.</u> | <u>1941 - George Blass, LS 5489</u> | <u>1968 - Carl Roser, LS 12028</u>                |
| #1 - 26" Pine S53°W 37 Links    | Iron pin set from found original    | Found iron pin and replaced with D.N.R. Monument. |
| #2 - 10" Pine N45°W 21 Links    | Government Bearing Trees            | #6 - 24" Oak N60°E 64.8'                          |
|                                 | #3 - 10 J. Pine S76°W 29.30'        | #7 - 26" Oak N30°W 82.50'                         |
|                                 | #4 - 14" B. Oak N27°W 66.30'        | #8 - 26" Oak S88°W 52.20'                         |
|                                 | #5 - 12" W. Oak S61°E 93.00'        |   |

B. Description of corner evidence found and/or method applied in restoring or reestablishing corner:  
M-5 & A-5 - Section corner common to Sections 12 & 13, T19N, R13W, AND Sections 7 and 18, T19N, R12W, Lake Co., Mi.

I found the D.N.R. Monument on the North edge of East and West road. I also found accessories No. 3, No. 5, No. 7 and No. 8 in good condition. Accessory No. 6 was found dead. Accessories No. 1 and No. 2 were gone.

ATTESTED BY THE LAKE CO. PEER REVIEW GROUP  
IN ACCORDANCE WITH P.A. 345  
CHAIRMAN R.G.W.  
DATE 11-12-96



C. Description of monument for corner and accessories established to perpetuate locating the position of the corner:

M-5 & A-5 - Section corner common to Sections 12 & 13, T19N, R13W, AND Sections 7 and 18, T19N, R12W, Lake Co., Mi.

I accepted the D.N.R. monument as a substantial monument for the corner, and is a perpetuation of the original corner.

- 32" B. Oak N86°W 53.72' (Found nail in S. side) #8
- 30" B. Oak N24°W 83.67' (Found nail in W. side) #7
- 6" B. Oak S81°E 29.30' (60d nail in N. side)
- 6" B. Oak S38°W 31.19' (60d nail in E. side)

Signed by Robert L. Wetherell Date 11-13-1996  
Surveyor's Michigan License No. 24624

177-178