

LAND CORNER RECORDATION CERTIFICATE

Filing Requirement of Act 74, Mich. PA 1970


| | | |
|---|---|---------------------------------|
| For Corners In: Lake _____ (County) _____ | Located In T <u>19N</u> R <u>13W</u> <u>I-7</u> T _____ R _____ | Corner Code # _____ _____ |
| 2. Property Controlling in Section | S _____ T _____ R _____ S _____ T _____ R _____ | _____ _____ |
| 3. Miscellaneous Property in Section | S _____ T _____ R _____ S _____ T _____ R _____ | _____ _____ |

Register of Deeds Stamp & File Number

4. Lot No: _____ Recorded Plat: _____

5. Private Claims: _____

I, Craig W. McVean, in a field survey on May 22, 2001 do hereby state that under requirements of PA 74, Michigan PA of 1970, the corner points mentioned in lines 1 and 2 above were in conformance with regulations and rules therefore as required in the current manual of survey instructions of the United States Department of the Interior, Bureau of Land Management or by a decree of a Court of Law and/or that the corner points mentioned in lines 3, 4 and 5 above were in conformance with the rules of the Michigan Board of Land Surveyors or by a Decree of a Court of Law; established, re-established, monumented, recovered, found as expressed below:

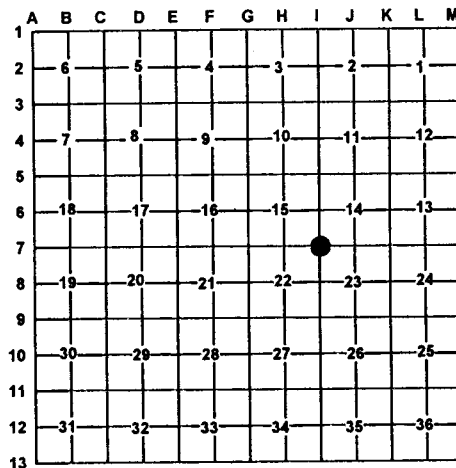

NOTE: Not more than 2 corners, all in the same town and range, may be recorded on this certificate.

A. Description of original monument and accessories and/or subsequent restoration:

- I-7 - GLO- Set Post S. Sibley- 1838
 Pine 10" S1°W 31L. Pine 6" N10°E 68L.
- MDOT Rd. plans - 1930- Proj. M043-12
 8.2 Rt. of Sta. 344+19 - 1/2" pipe
 N38°E 140.0' blazed 14" Oak N77°E 86.8' blazed 14" Oak
 N73°E 71.4' blazed 18" Oak
- G. Blass - 1960 - Set 5/8" boat spike in pavement from 1930
 MSHD wit.; Stp. of 14" Oak S77°E 86.8' (MSHD); 20" W.
 Oak N38°E 140.0' (MSHD); Tw. 12" B. Oak S47°W 72.70';
 USFS post N72°W 53.28'; Cor. 6.26' E of existing C/L
- LCRC L. 2 Pg. 78 - R.A. Griffin - 1973- Fd. 5/8" Boat spike and
 replaced with 5" sq. reinforced concrete post 3 foot in length and
 having a round 3" brass cap on top (properly stamped) - down 1'
 NW corner of Garage N79°E 141.75' ; 10" dock spike in S. Side 3"
 R. Pine S84°W 111.18'; RLS Tag # 13584 in N. side of a 4" Sq.
 X 7' Pine post west 99.77' ;
 RLS Tag # 13584 in SW side of Tele pole N28°W 114.93'

B. Description of corner evidence found and/or method applies in restoring or re-establishing corner:

- I-7 - Sec. corner common to section 14, 15, 22, & 23 - found 3" USFS brass cap on concrete post in mon. box per Griffin
 6.7' E of painted CL. of M-37. USFS Mon. accepted as the best available evidence of the position of the original corner

C. Description of monument for corner and accessories established to perpetuate locating the position of the corner:

- I-7 - USFS Monument in mon. box
 N87°W 99.50' to Fd. N&T in N. side USFS Wood Wit. Post (RAG)
 N36°E 140.41' to set N&T in NW side 26" W. Oak (MDOT, GB)
 S50°E 90.21' to set N&T in NE side 4" B. Oak
 S39°W 91.66' to set N&T in NW. side 18" B. Oak
 S86°E 21'E 93.87' to set 2" Alum. cap on 5/8" X 34" Rebar on Sec. line & E. ROW of M-37 & add Blue Carsonite post w/ loc. tag
 N79°E 141.75' to NW Cor. garage (RAG)



Signed by: Craig W. McVean
 Surveyor's Michigan License No.: 39088

Date 11/26/2001