

LAND CORNER RECORDATION CERTIFICATE

Filing Requirement of Act 74, Mich. PA 1970


For Corners In:			
Lake _____	Located In _____	Corner Code # _____	
(County) _____			
1. Public Land Survey	T <u>19N</u> R <u>13W</u>	<u>I-8</u>	
	T _____ R _____	_____	
2. Property Controlling in Section	S _____ T _____ R _____	_____	
	S _____ T _____ R _____	_____	
3. Miscellaneous Property in Section	S _____ T _____ R _____	_____	
	S _____ T _____ R _____	_____	

4. Lot No: _____ Recorded Plat: _____

5. Private Claims: _____

I, Craig W. McVean, in a field survey on May 22, 2001 do hereby state that under requirements of PA 74, Michigan PA of 1970, the corner points mentioned in lines 1 and 2 above were in conformance with regulations and rules therefore as required in the current manual of survey instructions of the United States Department of the Interior, Bureau of Land Management or by a decree of a Court of Law and/or that the corner points mentioned in lines 3, 4 and 5 above were in conformance with the rules of the Michigan Board of Land Surveyors or by a Decree of a Court of Law; established, re-established, monumented, recovered, found as expressed below:

NOTE: Not more than 2 corners, all in the same town and range, may be recorded on this certificate.

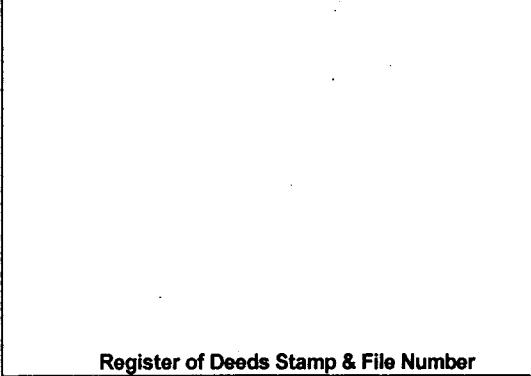

	A	B	C	D	E	F	G	H	I	J	K	L	M
1													
2	6			5		4		3		2		1	
3													
4	7			8		9		10		11		12	
5													
6	18			17		16		15		14		13	
7													
8	19			20		21		22	●	23		24	
9													
10	30			29		28		27		26		25	
11													
12	31			32		33		34		35		36	
13													

A. Description of original monument and accessories and/or subsequent restoration:

- I-8 - GLO.- Set ¼ post – S. Sibley – 1838
Pine 6" N7°W 15L.
Pine 8" S19°E 17L.
- Co. Sur. notes – stone 6" X 8" X 10"
for corner – (L. S. Cobb – 1878 ?)
Pine 10" S1°W 31L.
Pine 6" N10°E 20L.
- MDOT Rd. plans project # M043-12 (1930)
shows approx. ¼ cor. only. Shows fence to W.
midway between I-7 & I-9.

B. Description of corner evidence found and/or method applies in restoring or re-establishing corner:

I-8 - ¼ Corner common to section 22 & 23 – Could find no GLO evidence or BT's noted in Co. Sur. notes. Didn't excavate for stone since it falls on edge of M-37 bit. surface and is probably long removed by 1930 construction. 1930 MDOT plans note a fence to west at midway point +/- between I-7 & I-9 being a overall distance between I-7 & I-9 of 5449' per plan. Measured Grid distance of 5444.99' between I-7 & I-9. Thus set 4" DOC (DNR) brass cap on 1" X 36" Galv. Iron pipe w/ 6" PVC with concrete around cap set in mon. box by single proportion to I-7 to I-9. Painted C/L of M-37 is 13.3' +/- W. DOC (DNR) mon. on E. bit shoulder of M-37. DOC (DNR) mon. accepted as a careful & faithful reestablishment of the position of the original corner.

C. Description of monument for corner and accessories established to perpetuate locating the position of the corner:

I-8 – 4" DOC (DNR) Brass cap on 1" X 36' Galv. iron pipe with 6" PVC filled with concrete around cap- down 0.5' – in mon. box.
S87°37'12"E 87.24' to set 2" Alum. cap on 5/8" X34" rebar at E. ROW of M-37 & on E-W ¼ line . Added blue carsonite post with loc. tag on N. side.
N63°E 82.09' to N&T in NW side 11" W. Oak scribed 'XBT'
N52°W 97.05' to N&T in SW side 13" Oak scribed 'XBT'
S41°W 102.95' to N&T in E side 5" J. Pine scribed 'XBT'



Signed by: Craig W. McVean Date 11/26/2001
Surveyor's Michigan License No.: 39088