

**LAND CORNER RECORDATION CERTIFICATE**  
Filing Requirement of Act 74, Mich. PA 1970


For Corners In:				
Lake	Located In		Corner Code #	
(County)				
1. Public Land Survey	T 19N R 13W		K-7	
	T _____ R _____		_____	
2. Property Controlling in Section	S T _____ R _____		_____	
	S _____ T _____ R _____		_____	
3. Miscellaneous Property in Section	S T _____ R _____		_____	
	S _____ T _____ R _____		_____	

**Register of Deeds Stamp & File Number**

4. Lot No: \_\_\_\_\_ Recorded Plat: \_\_\_\_\_

5. Private Claims: \_\_\_\_\_

I, Craig W. McVean, in a field survey on June 18, 2001 do hereby state that under requirements of PA 74, Michigan PA of 1970, the corner points mentioned in lines 1 and 2 above were in conformance with regulations and rules therefore as required in the current manual of survey instructions of the United States Department of the Interior, Bureau of Land Management or by a decree of a Court of Law and/or that the corner points mentioned in lines 3, 4 and 5 above were in conformance with the rules of the Michigan Board of Land Surveyors or by a Decree of a Court of Law; established, re-established, monumented, recovered, found as expressed below:

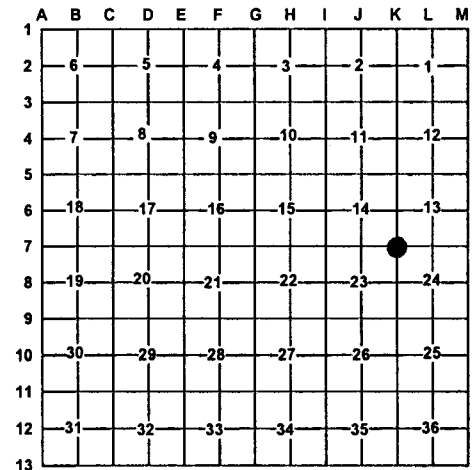

**NOTE: Not more than 2 corners, all in the same town and range, may be recorded on this certificate.**

**A. Description of original monument and accessories and/or subsequent restoration:**

<u>K-7</u> - GLO- Set Post S. Sibley- 1838 Pine 6" N6°E 31L. Pine 8" S20°W 39 L. - L.S. Cobb- 1878 - Stone 3" X 12" X 14" P. Pine 10" N52°W 26 L. ; P. Pine 8" S46°E 59 L. - G.N. West - 1908 - Fd. Stone Set by Lee S. Cobb 1878. NBT's J. Pine 9" S29 3/4 °E 69 1/2 L. J. Pine 14" N54°W 107 1/4 L.	- G. Blass - 1960 - found 1" iron gas pipe 36" in length in road with bottles around. 8" B. Oak N37°E 30.00' 6" J. Pine S33°E 39.04' 8" B. Oak N36°W 65.67' 6" J. Pine S75°W 67.10'
---	---

**B. Description of corner evidence found and/or method applies in restoring or re-establishing corner:**

K-7 - Sec. Cor. common to sections 13, 14, 23 & 24 - By excavation find L.S Cobb's 3" wide X 12" Deep X 14" Long Granite stone upright with rotten pine stake 3" long - remains along side . Stone was just under surface of existing ground. No evidence of BT's per Cobb or West but fits GLO survey well and West's survey to east. C/L of N-S sand Rd. is 39' West . Stone accepted as the best available evidence of the position of the original corner.

- Reference Pt. 'A' - Fd. 1" I.D. iron pipe w/ 2 whiskey bottles around in N-S sand Rd. per G. Blass is S82°18'W 37.61' of K-7. Blass found this pipe and used it to set J-7 & calculate L-7 at SP positions. This road couldn't have been here in 1908 since West's NW. BT. would have been in it. I can only speculate , but this pipe & road could possibly be the result of a CCC Survey and road building in the 1930's supervised by Frank Jones. 1" Iron pipe not utilized as K-7 in this survey.

**C. Description of monument for corner and accessories established to perpetuate locating the position of the corner:**

K-7 - Replaced 3" X 12" X 14" Granite Stone with 4" DOC (DNR) Alum. cap on 1" X 36" Galv. Iron pipe. Placed stone on N side & stake remains on S. side at base of monument as memorials. Added ring of Cobble stones.  
North 1' to set blue carsonite post  
N50°W 80.01' to set N&T in NE side 5" B. Oak scribed 'XBT'  
S28°W 141.80' to set N&T in NW side of 10" B. Oak scribed 'XBT'  
N64°E 94.67' to set N&T in NW. side of 10" R. Pine scribed 'XBT'  
S28°E 31.55' to set N&T in NE. side 4" R. Pine  
S82°18'W 37.61' to 1" iron pipe - Ref. Pt. 'A'



Signed by: Craig W. McVean  
Surveyor's Michigan License No.: 39088

Date 11/26/2001