

LAND CORNER RECORDATION CERTIFICATE

Filing Requirement of Act 74, Mich. PA 1970

| For Corners In: Lake (County) | Located In | Corner Code # |
|-----------------------------------------|-------------------------|---------------|
| 1. Public Land Survey | T 19N R 13W | K9 |
| | T _____ R _____ | _____ |
| 2. Property Controlling in Section | S _____ T _____ R _____ | _____ |
| | S _____ T _____ R _____ | _____ |
| 3. Miscellaneous Property in Section | S _____ T _____ R _____ | _____ |
| | S _____ T _____ R _____ | _____ |


4. Lot No: _____ Recorded Plat: _____

5. Private Claims: _____

I, Craig W. McVean, in a field survey on Aug 14, 2001 do hereby state that under requirements of PA 74, Michigan PA of 1970, the corner points mentioned in lines 1 and 2 above were in conformance with regulations and rules therefore as required in the current manual of survey instructions of the United States Department of the Interior, Bureau of Land Management or by a decree of a Court of Law and/or that the corner points mentioned in lines 3, 4 and 5 above were in conformance with the rules of the Michigan Board of Land Surveyors or by a Decree of a Court of Law; established, re-established, monumented, recovered, found as expressed below:

NOTE: Not more than 2 corners, all in the same town and range, may be recorded on this certificate.

Register of Deeds Stamp & File Number

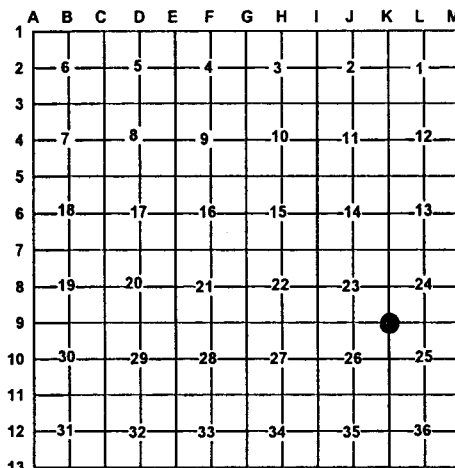

A. Description of original monument and accessories and/or subsequent restoration:

- K9 – GLO Post Cor. is a Pine 28" dia.- S. Sibley- 1838
 - L.S. Cobb Co. Surveyor – 1878 – Post Cor. is a Pine 28" W. Pine 22" S28 1/2°E 77L.
 Y. Pine 14" S71°W 81L.
 - G. Blass – 1954 – Fd. 3/4" x 24" iron pipe with stones around. Since no evidence to the contrary was present, it was accepted as the correct corner.
- 4" Maple N15°W 16.45', 7" W. Oak S38°E 33.90'
 5" W. Oak S5°E 26.13', 8" B. Oak S55°W 38.42'
 - LCRC L. 3, Pg.76 – C. F. Roser - 1988
 Fd. 3/4" Iron pipe per Blass raised with 5/8" x 17" rerod W/cap. ctr Line E-W gravel. rd. S. 5' +/- ; set cedar post with loc. tag S. 33' 9" W. Oak S35°W 49.50' 10" W. Oak S38°E 33.95'
 9" W. Oak S5°E 26.28'

B. Description of corner evidence found and/or method applies in restoring or re-establishing corner:

K-9 –Sec. Cor. common to 23,24,25 & 26- set 4" DOC (DNR) brass cap on 1" x 36" galv. Iron pipe w/ 6" x 1' PVC filled w/conc from remains of L.S. Cobb's SE BT. This corner position is verified by 1) A search south of the road reveals that this W.Pine stp. is of the correct size and the only W. Pine stp. in an area that appears undisturbed. 2) Corner position is 36' +/- E. of the C/L Merrillville Rd. (a straight N-S sand Rd.) extended S'ly which agrees with the position of Cobb's corners found to the N. K8 being 35' E of C/L Rd. & K7 being 39' E of the C/L Rd. 3) the 1/4 Corners N, S & E at K8, K10, L9 (all being Cobb corner perpetuation's) are all nearly midway & on line between the sec. corners as they should be. 4) E-W proportion for 1 Mile E & W to GLO is within 3' of this position. 5) The pine corner tree was obviously obliterated during construction of the road but we excavated a 4' long hole from BT and found much evidence of burnt & rotten pine roots 2.5' to 3' down. Since Cobb had original corner tree the DOC (DNR) monument at Cobb's position is accepted as a careful & faithful perpetuation of the position of the original corner.

- Reference Pt. 'D' - N75°52'W 37.08' to fd. capped 5/8" per Roser at Blass position from K9. This position is in line with the centerline of Merrillville Rd. extended S'ly. This position doesn't fit Cobb's position of corners N,S,E&W as noted above. I can only speculate that this position may have been established during the construction of Merrillville Rd. to the N. possibly by F. Jones 1930's CCC rd. survey. Capped 5/8" rebar in 3/4" pipe not accepted as K9 in his survey. Removed Roser's cap on iron.

C. Description of monument for corner and accessories established to perpetuate locating the position of the corner:

K-9 – 4" DOC (DNR) brass cap on 1" X 36" Galv. iron pipe w/ 6" x 1' Long PVC filled with concrete around cap- down 1' S28°30'E 51.74' to set 1/2" x 24" Rebar in C/L Remains 22" WPS (LSC)
 South 33.04' to 2" Alum cap on 5/8" X 34" Rebar on line with Reset Cedar post with location tag
 S29°W 36.61' to set N&T in NW side 7" R. Maple scribed 'XBT'
 S66°W 95.42' to set N&T in SE side 6" W. Pine scribed 'XBT'
 N5°E 111.14' to set N&T in E. side 6" W. Pine scribed 'XBT'
 N75°52' W 37.08' to Ref. Pt. 'D'



Signed by: Craig W. McVean
 Surveyor's Michigan License No.: 39088

Date 11/26/2001