

LAND CORNER RECORDATION CERTIFICATE

Filing Requirement of Act 74, Mich. PA 1970

For Corners In:
 Lake _____ Located In _____ Corner Code # _____
 (County) _____

1. Public Land Survey T _____ R _____
 T _____ R _____

2. Property Controlling in Section S 13 T 19N R 13W 7
 S 13 T 19N R 13W C-E-W1/64

3. Miscellaneous Property in Section S _____ T _____ R _____
 S _____ T _____ R _____


4. Lot No: _____ Recorded Plat: _____

5. Private Claims: _____

I, Craig W. McVean, in a field survey on May 16, 2001 do hereby state that under requirements of PA 74, Michigan PA of 1970, the corner points mentioned in lines 1 and 2 above were in conformance with regulations and rules therefore as required in the current manual of survey instructions of the United States Department of the Interior, Bureau of Land Management or by a decree of a Court of Law and/or that the corner points mentioned in lines 3, 4 and 5 above were in conformance with the rules of the Michigan Board of Land Surveyors or by a Decree of a Court of Law; established, re-established, monumented, recovered, found as expressed below:

NOTE: Not more than 2 corners, all in the same town and range, may be recorded on this certificate.

Register of Deeds Stamp & File Number

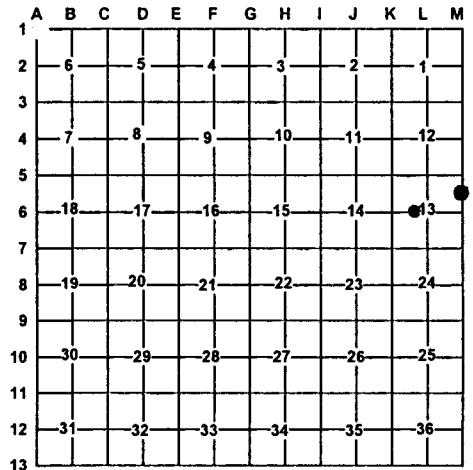

A. Description of original monument and accessories and/or subsequent restoration:

7- G. -Blass-1941 set corner C-E-W 1/64- G. Blass -1967 - iron survey marker.
 -DNR survey project #68-31, C. Roser - 1968
 Set 1" pipe over found old 1/2" pipe buried.
 Also found 1/2" pipe south 34.4',



B. Description of corner evidence found and/or method applies in restoring or re-establishing corner:

7- N1/16 corner common to section 13, T19N,R13W and section 18, T19N,R12W – Corner area appears to be disturbed. Found leaning 1/2" pipe .51' South and 0.1' West of calculated position. Also found disturbed (we straighten up) 1" iron pipe over 1/2" iron pipe (Roser's monument probably) 3.36' north and 0.8' West of calculated position. Also found 1/2" iron pipe 34.42' South of calculated position, undisturbed. Thus I set 2" aluminum cap on 5/8" X 34" rebar per standard BLM procedure at calculated position that fits 1/2" pipe 34.42' South.

C-E-W 1/64 - SW corner of East 1/2 of SE 1/4 of NW 1/4 of section 13. Blass iron had been plowed out since position falls on West edge of Snowmobile and ORV trail. Set 2" Aluminum cap on 5/8" x 34" rebar per standard BLM procedure. Fits Blass survey distances North and West.

C. Description of monument for corner and accessories established to perpetuate locating the position of the corner:

7- 2" Aluminum cap on 5/8" X 34" rebar C-E-W 1/64 - 2" Aluminum cap on 5/8" X 34" rebar-Down .5'
 SE 1' to set blue carsonite post with location tag West 10' to set blue carsonite post with location tag
 South 34.42' to fd. 1/2" iron pipe (CR) N76°E 89.97' to nail and tag in North side of 20" W. Oak
 S53°W 24.37' to nail and tag in NW side of 7" W. Pine S57°E 98.69' to nail and tag in south side 6" J. Pine
 S27°E 22.06' to nail and tag in West side of 16" R. Maple S48W 12.67' to nail and tag in SE side 3" B. Oak
 S76°E 26.47' to nail and tag in SW side of 13" W. Pine N24°E 51.54' to nail and tag in NW side 20" W. Oak
 South edge of stream is 93± North

Signed by: Craig W. McVean
 Surveyor's Michigan License No.: 39088

Date: 11/26/2001