

LAND CORNER RECORDATION CERTIFICATE

Filing Requirement of Act 74, Mich. PA 1970

For Corners In: Lake _____ (County) _____	Located In T _____ R _____ T _____ R _____	Corner Code # _____ _____ _____ _____
1. Public Land Survey	T _____ R _____	_____
2. Property Controlling in Section	S 13 T 19N R 13W	9
	S 14 T 19N R 13W	16
3. Miscellaneous Property in Section	S _____ T _____ R _____	_____
	S _____ T _____ R _____	_____


4. Lot No: _____ Recorded Plat: _____

5. Private Claims: _____

I, Craig W. McVean, in a field survey on June 5, 2001 do hereby state that under requirements of PA 74, Michigan PA of 1970, the corner points mentioned in lines 1 and 2 above were in conformance with regulations and rules therefore as required in the current manual of survey instructions of the United States Department of the Interior, Bureau of Land Management or by a decree of a Court of Law and/or that the corner points mentioned in lines 3, 4 and 5 above were in conformance with the rules of the Michigan Board of Land Surveyors or by a Decree of a Court of Law; established, re-established, monumented, recovered, found as expressed below:

NOTE: Not more than 2 corners, all in the same town and range, may be recorded on this certificate.

Register of Deeds Stamp & File Number

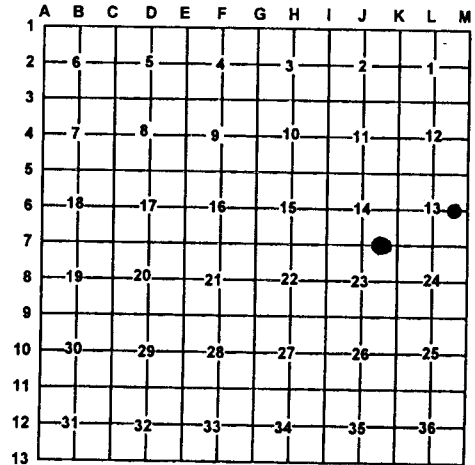

A. Description of original monument and accessories and/or subsequent restoration:

- 9- Recorded Survey L.1, P. 291. Survey marker Set-1978, R.L. Wetherall
- 16- G. Blass, 1960- Set 1/2" iron pipe.



B. Description of corner evidence found and/or method applies in restoring or re-establishing corner:

- 9-CE 1/16 corner section 13- Found 1/2" capped iron #17615-19305-24624-. Moto-cross trail is 14'± N. 1/2" capped iron rod accepted at the best available evidence of the position of the center
- 16-E 1/16 corner common to section 14 and 23. Set 2" aluminum cap on 5/8" X 34" rebar per standard BLM procedure.
- Reference Point 'E'- Found 1/2" iron pipe per Blass-S 82°44'W 18.77' of '16'. Blass pipe based on rejected monument (3/4" pipe) that is S82°18'W 37.62' of K7 (DNR monument replacing L.S. Cobb's stone from 1878). 1/2" iron pipe not utilized as 1/16 in this survey.

C. Description of monument for corner and accessories established to perpetuate locating the position of the corner:

- 9- Replaced 1/2" capped iron rod with 2" aluminum cap on 5/8" x 34" rebar
 NE 1' to set blue carsonite post with location tag
 N56°E 27.58' to nail and tag in NW side of 9" J. Pine
 N84°E 24.14' to nail and tag in side of 14" J. Pine
 S84°W 6.14' to nail and tag in side of 10" W. Oak
 N8°W 6.94 to nail and tag in side of 10" J. Pine
- 16- 2" aluminum cap on 5/8" X 34" rebar
 SE 1' to set blue carsonite post w/ Loc. tag
 N45°W14.74' to nail and tag in SW side of 4" R. Pine
 N32°E 48.07' to nail and tag in West side of 5" R. Pine
 S54°E 8.79' to nail and tag in SW side of 4" J. Pine
 S82°44'W 18.77' to 1/2" iron pipe -Reference point 'E'

Signed by: Craig W. McVean
 Surveyor's Michigan License No.: 39088

Date: 11/26/2001