

NOV 21 1997

COMMISSION

LAND CORNER RECORDATION CERTIFICATE
Filing Requirement of Act 74, Mich. P.A. 1970

RECORDED LAKE COUNTY, MI. LIBER 004 PAGE 0062

OCT 29 2 58 PM '97

REGISTER OF DEEDS

Register of Deeds Stamp & File Number

For corners in

Table with columns: Lake (County), Located In: (19N, 14W), Corner Code # (E-3). Rows include Public Land Survey, Property Controlling in Section, and Miscellaneous Property in Sec.

4. Lot No. Recorded Plat
5. Private Claims

Robert L. Wetherell, September 22, 1997
do hereby certify that under requirements of P.A. 74, Michigan P.A. of 1970, the corner points mentioned in lines 1 and 2 above were in conformance with regulations and rules therefore as required in the current manual of survey instructions of the United States Department of the Interior, Bureau of Land Management or by a decree of a Court of Law and/or that the corner points mentioned in lines 3, 4 and 5 above were in conformance with the rules of the Michigan Board of Land Surveyors or by a Decree of a Court of Law, established, re-established, monumented, re-monumented, recovered, found as expressed below:

NOTE: Not more than 4 corners, all in the same town and range, may be recorded on this certificate.

A. Description of original monument and accessories and/or subsequent restoration:

E-3 - Section corner common to Sections 4, 5, 8 & 9, T19N, R14W, Lake Co., Mi.

1838 - S. Sibley, G.L.O.

#1 - 10" Pine N10E 12 Links

#2 - 10" Pine S40W 10 Links

1908 - J.W. Nicholson, Co. Sur.

#3 - 20" Pine Stump S52E 56 Links

#4 - 24" P. Stump N34W 18 Links

Undated - George Johnson, Co. Sur.

#5 - 12" W. Oak N6730E 152.2'

#3 - Old Stump S52E 37'

#6 - 14" W. Oak N3630W 44'

#7 - 10" W. Oak N4W 156.8'

1965 - Robert Griffin, LS 13584

L.C.R.C. - Liber 01, Pg. 192

Found 3/4" Iron Pipe

Replaced with 5" Square Concrete Monument

#8 - 5" Maple S40E 75.62'

#9 - P. Pole S71W 53.60'

#6 - 23" W. Oak N3630W 44.96'

#10 - S.W. Cor. Concrete Wall N34E 44.30'


B. Description of corner evidence found and/or method applied in restoring or reestablishing corner:

E-3 - Section corner common to Sections 4, 5, 8 & 9, T19N, R14W, Lake Co., Mi.

I found the 5" Square Concrete Monument set by Griffin.

condition of the accessories are as follows: #1 Gone, #2 Gone, #3 Gone, #4 gone, #5, Gone, #6 Found in good condition, #7 Gone, #8 Found in good condition, #9 Found in good condition, #10 Found in good condition.

RATIFIED BY THE LAKE CO. REEVALUATION GROUP
IN ACCORDANCE WITH ACT 74, MICH. P.A. 1970
DATE 10-23-97

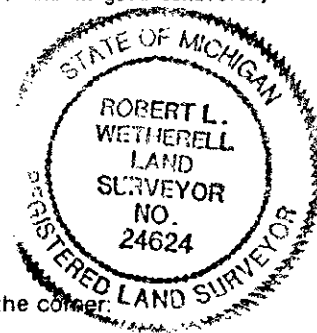

C. Description of monument for corner and accessories established to perpetuate locating the position of the corner:

E-3 - Section corner common to Sections 4, 5, 8 & 9, T19N, R14W, Lake Co., Mi.

I accepted the 5" Square Concrete Monument as a substantial monument for the corner, and is accepted as a careful and faithful re-establishment of the position of the original corner.

- 8" Maple S36E 75.68' (dock spike in N.E. side) #8
Power Pole S75W 53.56' (Nail & Washer in S. side) #9
32" W. Oak N32W 44.88' (60d spike in S.W. side) #6
8" Maple N73E 109.27' (60d spike in S. side)
8" W. Pine S70E 145.56'

Signed by Robert L. Wetherell Date 10-28-97

Surveyor's Michigan License No. 24624