

NOV 21 1997

COMMISSION

LIBER 004 PAGE 0065

LAND CORNER RECORDATION CERTIFICATE
Filing Requirement of Act 74, Mich. P.A. 1970

For corners in

Table with columns: Lake (County), Located In: (19N, 14W), Corner Code (F-3). Rows include Public Land Survey, Property Controlling in Section, and Miscellaneous Property in Sec.


REGISTERED RECORDING REGISTER OF DEEDS LAKE COUNTY, MI. Oct 29 2 58 PM '97

Register of Deeds Stamp & File Number

4. Lot No. , Recorded Plat
5. Private Claims

Robert L. Wetherell September 22, 1997

I, do hereby certify that under requirements of P.A. 74, Michigan P.A. of 1970, the corner points mentioned in lines 1 and 2 above were in conformance with regulations and rules therefore as required in the current manual of survey instructions of the United States Department of the Interior, Bureau of Land Management or by a decree of a Court of Law and/or that the corner points mentioned in lines 3, 4 and 5 above were in conformance with the rules of the Michigan Board of Land Surveyors or by a Decree of a Court of Law; established, re-established, monumented, re-monumented, recovered, found as expressed below:

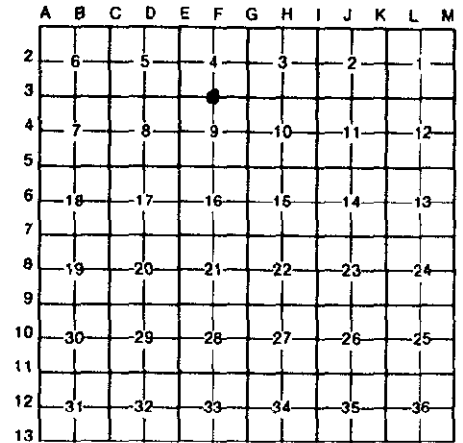

NOTE: Not more than 4 corners, all in the same town and range, may be recorded on this certificate.

A. Description of original monument and accessories and/or subsequent restoration:

F-3 - 1/4 Corner common to Sections 4 & 9, T19N, R14W, Lake Co., Mi.

- 1838 - S. Sibley, G.L.O. #1 - 8" Beech N27°E 7 Links #2 - 8" Oak S16°W 15 Links 1908 - J.W. Nicholson, Co. Sur. "Found Old Post in Cranberry Marsh" #3 - Dead Tamarack S17°W 26 Links
1951 - George Blass, LS 5489 "Located from Nicholson's notes" Found 4" Square cedar stake scribed 1/4 corner on two sides. Reset a new 4" Square Tamarack Stake. "No witnesses available"
1965 - Robert Griffin, LS 13584 L.C.R.C. - Liber 01, Page 202. Found 4" Square Tamarack stake replaced with 5" Square Concrete Monument #4 - 8" R. Oak S61°E 240.10' #5 - 3" R. Pine N68°W 124.82' #6 - 13" W. Oak N1°W 143.35'

B. Description of corner evidence found and/or method applied in restoring or reestablishing corner:

F-3 - 1/4 Corner common to Sections 4 & 9, T19N, R14W, Lake Co., Mi.

I found the 5" Square Concrete Monument by Griffin in Cranberry bog at the intersection of fences North and West. Condition of the accessories are as follows: #1 Gone, #2 gone, #3 Gone, #4 Found in good condition, #5 Gone, #6 Found in good condition,

RATIFIED BY THE LAKE CO. PEER REVIEW GROUP IN ACCORDANCE WITH P.A. 345 CHAIRMAN DATE 10-23-97

C. Description of monument for corner and accessories established to perpetuate locating the position of the corner:

F-3 - 1/4 Corner common to Sections 4 & 9, T19N, R14W, Lake Co., Mi.

I accepted the 5" Square Concrete Monument as a substantial marker for the corner, and is accepted as a careful and faithful re-establishment of the position of the original corner.

- 5" Tamarack S28°W 135.93' (60d spike in W. side) Power Pole N80°E 202.70' (60d spike in N. side) 12" R. Oak S58°E 239.66' (dock spike in N. side) #4 17" W. Oak N1°E 143.04' (dock spike in W. side) #6

Surveyed by Robert L. Wetherell 24624

Date 10-28-97

Surveyor's Michigan License No.

