

NOV 21 1997

LIBER 004 PAGE 0066

LAND CORNER RECORDATION CERTIFICATE
Filing Requirement of Act 74, Mich. P.A. 1970

For corners in

Table with columns: Lake (County), Located In: (19N, 14W), Corner Code # (G-2). Rows include Public Land Survey, Property Controlling in Section, Miscellaneous Property in Sec.

RECORDED LAKE COUNTY, MI.
REGISTER OF DEEDS
Oct 29 2 59 PM '97
Hester H. Deans

Register of Deeds Stamp & File Number

- 4. Lot No.
5. Private Claims

Grid table with columns A-M and rows 2-13. A dot is marked at the intersection of column G and row 2.

I, Robert L. Wetherell, September 22, 1997, do hereby certify that under requirements of P.A. 74, Michigan P.A. of 1970, the corner points mentioned in lines 1 and 2 above were in conformance with regulations and rules therefore as required in the current manual of survey instructions of the United States Department of the Interior, Bureau of Land Management or by a decree of a Court of Law and/or that the corner points mentioned in lines 3, 4 and 5 above were in conformance with the rules of the Michigan Board of Land Surveyors or by a Decree of a Court of Law; established, re-established, monumented, re-monumented, recovered, found as expressed below:

NOTE: Not more than 4 corners, all in the same town and range, may be recorded on this certificate.

A. Description of original monument and accessories and/or subsequent restoration:


- 1838 - S. Sibley, G.L.O. #1 - 10" Pine N78°E 13 Links #2 - 8" Pine S53°W 27 Links
1908 - J.W. Nicholson, Co. Sur. "In Lake and always has been. Can find no one whoever saw the the post mentioned in field notes".
1908 - W.A. Seaman (Land Looker) In a letter to J.W. Nicholson. Stated the G.L.O. was a fraud and that a Mr. Lyons sent surveyor Mitchell from Ludington to set this corner.

(SEE OVER FOR CONTINUATION OF "A")

B. Description of corner evidence found and/or method applied in restoring or reestablishing corner:

G-2 - 1/4 corner common to Sections 3 & 4, T19N, R14W, Lake Co., Mi.

I found 1/2" pipe on edge of Loon Lake. Corner is 60 feet more or less Northerly of centerline of black top road. Condition of the accessories are as follows: #1 Gone, #2 gone, #3 Found Stump, #4 Found Stump, #5 Found in good condition.

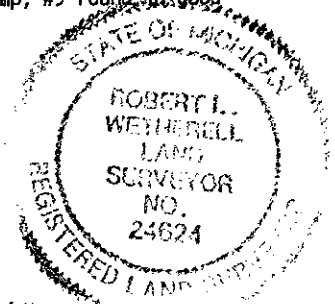

RATIFIED BY THE LAKE CO. PEER REVIEW GROUP IN ACCORDANCE WITH P.A. 345 CHAIRMAN R.W. DATE 10-23-97

C. Description of monument for corner and accessories established to perpetuate locating the position of the corner:

G-2 - 1/4 corner common to Sections 3 & 4, T19N, R14W, Lake Co., Mi.

I replaced the 1/2" pipe with a 3/4" x 24" re-bar with Lake County Brass Cap, and is accepted as a careful and faithful re-establishment of the position of the original corner.

- Northeast corner of Concrete Step (bottom step) S43°W 17.20'
Maple Clump S35°W 20.64' (60d spike in W. side)
7" Tw. Elm N64°W 25.90' (60d spike in N. side)
11" Beech S1°E 33.20' (60d spike in W. side)

Signed by Robert L. Wetherell Date 10-28-97

Surveyor's Michigan License No. 24624

NOV 21 1997

LIBER 004 PAGE 0067

CONTINUATION OF "A" - DESCRIPTION OF ORIGINAL MONUMENT AND ACCESSORIES AND/OR SUBSEQUENT RESTORATION:

1938 - D.S. Hazelton

Surveyed the N.E.1/4 of Section 4, and his map showed this corner in Loon Lake.

1953 - George Blass, LS 5489

Found wood stake on beach of Loon Lake in line with fence to West. Replaced stake with 1/2" Pipe.

#3 - 14" Maple S8°W 16.50'

#4 16" Maple S42°E 50.20'

1954 - George Blass, LS 5489

Developed plat of "Martha & Earl Waites plat of Loon Lake View". Showed corner in Lake (no distance given)

1990 - Clinton E. Cole, LS 17615

#3 - 18" Maple S8°W 16.50'

#4 - 16" Maple S42°E 50.20'

#5 - Set capped iron South 12.31'