

NOV 21 1997

COMMISSION

LAND CORNER RECORDATION CERTIFICATE
Filing Requirement of Act 74, Mich. P.A. 1970

RECORDED LAKE COUNTY, MI. LIBER 004 PAGE 0063

OCT 29 2 58 PM '97

REGISTER OF DEEDS

For corners in

Table with columns: Lake (County), Located In: (19N, 14W), Corner Code (G-3). Rows include Public Land Survey, Property Controlling in Section, and Miscellaneous Property in Sec.

Register of Deeds Stamp & File Number

4. Lot No. , Recorded Plat
5. Private Claims

Grid table with columns A-L and rows 2-13. A small black dot is present in the grid at row 4, column G.

Robert L. Wetherell, September 22, 97
I, in a field survey on 19
do hereby certify that under requirements of P.A. 74, Michigan P.A. of 1970, the corner points mentioned in lines 1 and 2 above were in conformance with regulations and rules therefore as required in the current manual of survey instructions of the United States Department of the Interior, Bureau of Land Management or by a decree of a Court of Law and/or that the corner points mentioned in lines 3, 4 and 5 above were in conformance with the rules of the Michigan Board of Land Surveyors or by a Decree of a Court of Law; established, re-established, monumented, re-monumented, recovered, found as expressed below:

NOTE: Not more than 4 corners, all in the same town and range, may be recorded on this certificate.

A. Description of original monument and accessories and/or subsequent restoration:

- 1838 - S. Sibley, G.L.O. 1927 - George Johnson, Co. Sur.
#1 - 8" Beech S23°W 23 Links Iron Spike
#2 - 14" W. Oak N35°E 16 Links #4 - 20" W. Oak S27°45'E 108'
#3 - 3" W. Oak N60-3/4°E 54 Links #5 - 10" Maple N80°45'E 78.5'

- 1950 - George Blass, LS 5489
Found 4" x 4" Conc. Post - Raised with 1" Iron Rod with stones and glass around
#6 - 24' W. Oak N87°W 50.00'
#7 - Fence Post South 47.60'
#5 - 14" Maple N32°E 78.50'
#4 - 30" W. Oak S27°E 108.0'

(SEE OVER FOR CONTINUATION OF "A")

B. Description of corner evidence found and/or method applied in restoring or reestablishing corner:

G-3 - Section corner common to Sections 3, 4, 9 & 10, T19N, R14W, Lake Co., Mi.

I found a 5" Square Concrete Monument in road intersection.

Condition of the accessories are as follows: #1 Gone, #2 Gone, #3 Gone, #4 Found 35" Stump #5, Gone, #6 Gone, #7 Gone, #8 Found in good condition, #9 Gone #10 Found in good condition, #11 Found in good condition, #12 Found in good condition.

RATIFIED BY THE LAKE CO. PEER REVIEW GROUP IN ACCORDANCE WITH P.A. 345 CHAIRMAN R.L.W. DATE 10-23-97

C. Description of monument for corner and accessories established to perpetuate locating the position of the corner:


G-3 - Section corner common to Sections 3, 4, 9 & 10, T19N, R14W, Lake Co., Mi.

I accepted the 5" Square Concrete Monument as a substantial marker for the corner, and is accepted as a careful and faithful re-establishment of the position of the original corner.

- 11" B. Oak N54°E 69.90' (Center of Tree)
Power Pole N65°W 25.18' (60d spike in S. side)
11" Tw. W. Oak S50°E 68.10' (60d spike in N.E. side)
8" W. Oak S52°E 117.48' (dock spike in S.W. side) #10

igned by Robert L. Wetherell 24624

Date 10-28-97

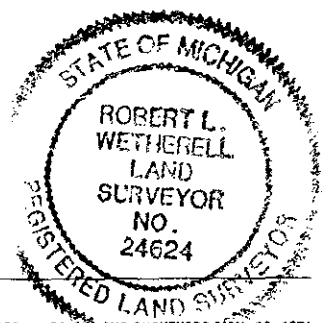

urveyor's Michigan License No.

NOV 21 1987

COMMISSION

CONTINUATION OF "A" - DESCRIPTION OF ORIGINAL MONUMENT AND ACCESSORIES AND/OR SUBSEQUENT RESTORATION:

1954 - George Blass, LS 5489

Developed plat of "Martha and Earl Waite's Plat of Loon Lake View"
This corner is Southeast corner of plat.
#8 - Concrete Monument 33.00 feet West

1965 - Robert Griffin, LS 13584

L.C.R.C. - Liber 01, Pg. 206
Found 4" x 4" Concrete Post (Broken)
Replaced with 5" Square Concrete Monument
#9 - Telephone Pole N19°E 100'
#10 - 7" W. Oak S52°E 117.48'
#4 - 24" W. Oak S27°E 108.60'
#11 - 5" Concrete Monument S1°10'W 275.10' (meander corner)
#8 - Concrete Monument N87°45'W 33.00 feet

1975 - Clinton E. Cole, LS 17615

Developed plat of "Timber Shores Estates"
#12 - Concrete Monument South 59.66'