

MAY 10 1987

COMMISSION

LAND CORNER RECORDATION CERTIFICATE
Filing Requirement of Act 74, Mich. P.A. 1970

LIBER003 PAGE 0399

For corners in

Lake (County)	Located In:		Corner Code #
	19N	14W	
1. Public Land Survey	T	R	G-9
	T	R	
	T	R	
	T	R	
2. Property Controlling in Section	S	T	R
	S	T	R
3. Miscellaneous Property in Sec.	S	T	R
	S	T	R

RECORDED
LAKE COUNTY, MI.

Nov 14 11 26 AM '96

REGISTER OF DEEDS

Register of Deeds Stamp & File Number

- 4. Lot No. _____, Recorded Plat _____
- 5. Private Claims _____

	A	B	C	D	E	F	G	H	I	J	K	L	M
2	6	5	4	3	2								
3													
4	7	8	9	10	11	12							
5													
6	18	17	16	15	14	13							
7													
8	19	20	21	22	23	24							
9													
10	30	29	28	27	26	25							
11													
12	31	32	33	34	35	36							
13													

I, Robert L. Wetherell, in a field survey on November 11, 1996, do hereby certify that under requirements of P.A. 74, Michigan P.A. of 1970, the corner points mentioned in lines 1 and 2 above were in conformance with regulations and rules therefore as required in the current manual of survey instructions of the United States Department of the Interior, Bureau of Land Management or by a decree of a Court of Law and/or that the corner points mentioned in lines 3, 4 and 5 above were in conformance with the rules of the Michigan Board of Land Surveyors or by a Decree of a Court of Law; established, re-established, monumented, re-monumented, recovered, found as expressed below:

NOTE: Not more than 4 corners, all in the same town and range, may be recorded on this certificate.

- A. Description of original monument and accessories and/or subsequent restoration:
G-9 - Section corner common to Sections 21, 22, 27 & 28, T19N, R14W, Lake County, Mi.
- | | |
|-------------------------------------|---|
| <u>1838 - S. Sibley, G.L.O.</u> | <u>1965 - Robert Griffin, LS 13584</u> |
| <u>#1 - 4" Cherry S6°W 7 Links</u> | <u>L.C.R.C. - Liber 01, Page 213</u> |
| <u>#2 - 5" Maple N71°E 17 Links</u> | <u>Found 4" x 48" Concrete Monument at fence intersection.</u> |
| | <u>A local resident told him fences were built about 1910.</u> |
| | <u>Griffin replaced 4" Concrete Monument with 5" x 60" Concrete Monument.</u> |
| | <u>#3 - 11" W. Pine S88°E 59.71'</u> |
| | <u>#4 - 6" Maple S35°E 64.72'</u> |
| | <u>#5 - 6" W. Oak S48°W 68.72'</u> |
| | <u>#6 - 7" R. Oak N68°W 19.18'</u> |


B. Description of corner evidence found and/or method applied in restoring or reestablishing corner:

G-9 - Section corner common to Sections 21, 22, 27 & 28, T19N, R14W, Lake County, Mi.

I found a 5" x 60" Concrete Monument at intersection of old fences North and West.

Condition of accessories are as follows: #1 Gone, #2 Gone, #3 Found leaning, #4 Found in good condition, #5 Found in good condition, #6 Found down.

RATIFIED BY THE LAKE CO. PEER REVIEW GROUP
 IN ACCORDANCE WITH P.A. 345
 CHAIRMAN R. X. W.
 DATE 11-12-96

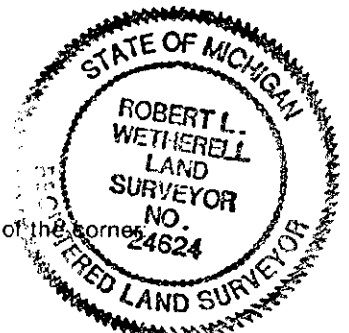

C. Description of monument for corner and accessories established to perpetuate locating the position of the corner:

G-9 - Section corner common to Sections 21, 22, 27 & 28, T19N, R14W, Lake County, Mi.

I accepted the 5" x 60" Concrete Monument as a substantial monument for the corner, and is accepted as a careful and faithful re-establishment of the position of the original corner.

- 12" Maple S27°E 64.79' (dock spike in E. side) #4
- 9" W. Oak S54°W 68.76' (dock spike in S.E. side) #5
- 12" Maple N89°E 88.82' (60d spike in S. side)
- 7" Hemlock N10°W 46.17' (60d spike in E. side)

Signed by Robert L. Wetherell Date 11-13-1996

Surveyor's Michigan License No. 24624