

MAY 16 1997

COMMISSION

LAND CORNER RECORDATION CERTIFICATE
Filing Requirement of Act 74, Mich. P.A. 1970

LIBER 003 PAGE 0400

For corners in

Lake (County)	Located In:		Corner Code #
	19N	14W	
1. Public Land Survey	T	R	H-9
	T	R	
	T	R	
	T	R	
2. Property Controlling in Section	S	T	R
	S	T	R
3. Miscellaneous Property in Sec.	S	T	R
	S	T	R

RECORDED
LAKE COUNTY, MI.
NOV 14 11 26 AM '96
REGISTER OF DEEDS
Register of Deeds Stamp & File Number

- 4. Lot No. _____ Recorded Plat _____
- 5. Private Claims _____

A	B	C	D	E	F	G	H	I	J	K	L	M
2	6	5	4	3	2	1						
3												
4	7	8	9	10	11	12						
5												
6	18	17	16	15	14	13						
7												
8	19	20	21	22	23	24						
9												
10	30	29	28	27	26	25						
11												
12	31	32	33	34	35	36						
13												

I, Robert L. Wetherell, in a field survey on November 11, 1996, do hereby certify that under requirements of P.A. 74, Michigan P.A. of 1970, the corner points mentioned in lines 1 and 2 above were in conformance with regulations and rules therefore as required in the current manual of survey instructions of the United States Department of the Interior, Bureau of Land Management or by a decree of a Court of Law and/or that the corner points mentioned in lines 3, 4 and 5 above were in conformance with the rules of the Michigan Board of Land Surveyors or by a Decree of a Court of Law; established, re-established, monumented, re-monumented, recovered, found as expressed below:

NOTE: Not more than 4 corners, all in the same town and range, may be recorded on this certificate.

A. Description of original monument and accessories and/or subsequent restoration:

H-9 - 1/4 Corner common to Sections 22 & 27, T19N R14W, Lake County, Mi.
 1838 - S. Sibley, G.L.O. 1990 - Clinton E. Cole, LS 17615
 #1 - 5" Maple S68°W 8 Links L.C.R.C. - Liber 03, Page 112.
 #2 - 5" Maple N51-1/2°E 40 Links Under contract with U.S.F.S. established corner by single proportionate method. 2554.63' to each Sec. corner. Set a 2" Galvanized pipe with Brass Cap.
 #3 - 9" R. Oak S32°W 80.42'
 #4 - 6" W. Oak S6°E 75.98'
 #5 - 6" W. Oak S60°E 151.80'
 #6 - 5" Maple N75°E 157.73'

B. Description of corner evidence found and/or method applied in restoring or reestablishing corner:

H-9 - 1/4 Corner common to Sections 22 & 27, T19N R14W, Lake County, Mi.
 I found a 2" Galvanized Pipe with Brass Cap. I measured 2552.91 feet East to the Section corner and 2554.68 feet West to the Section corner.

Accessories No. 1 and No. 2 were not recovered, accessories No. 3 thru No. 6 were found in good condition.


RATIFIED BY THE LAKE CO. PEER REVIEW GROUP
 IN ACCORDANCE WITH P.A. 345
 CHAIRMAN R.L.W.
 DATE 11-12-96

C. Description of monument for corner and accessories established to perpetuate locating the position of the corner:

H-9 - 1/4 Corner common to Sections 22 & 27, T19N R14W, Lake County, Mi.
 I accepted the 2" Galvanized Pipe as a substantial monument for the corner, and is accepted as a careful and faithful re-establishment of the position of the original corner.

- 6" W. Oak S06°E 76.01' (60d spike in E. side) #4
- 13" B. oak S34°W 80.41' (60d spike in W. side) #3
- 6" W. oak S56°E 151.82' (60d spike in N.E. side) #5
- 6" Maple N80°E 157.77' (60d spike in N. side) #6

Signed by Robert L. Wetherell Date 11-13-1996
 24624

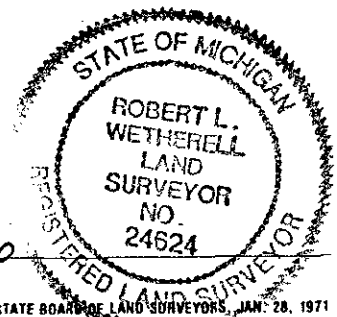

Surveyor's Michigan License No. _____

180