

MAY 16 1987

COMMISSION

LAND CORNER RECORDATION CERTIFICATE
Filing Requirement of Act 74, Mich. P.A. 1970

LIBER 003 PAGE 0401

For corners in

Lake (County)	Located In:		Corner Code #
	19N	14W	
1. Public Land Survey	T	R	I-9
	T	R	
	T	R	
	T	R	
2. Property Controlling in Section	S	T	R
	S	T	R
3. Miscellaneous Property in Sec.	S	T	R
	S	T	R

RECORDED
LAKE COUNTY, MI.

Nov 14 11 26 AM 1986

REGISTER OF DEEDS

Register of Deeds Stamp & File Number


4. Lot No. _____, Recorded Plat _____

5. Private Claims _____

I, Robert L. Wetherell, in a field survey on November 11, 1996

do hereby certify that under requirements of P.A. 74, Michigan P.A. of 1970, the corner points mentioned in lines 1 and 2 above were in conformance with regulations and rules therefore as required in the current manual of survey instructions of the United States Department of the Interior, Bureau of Land Management or by a decree of a Court of Law and/or that the corner points mentioned in lines 3, 4 and 5 above were in conformance with the rules of the Michigan Board of Land Surveyors or by a Decree of a Court of Law; established, re-established, monumented, re-monumented, recovered, found as expressed below:

NOTE: Not more than 4 corners, all in the same town and range, may be recorded on this certificate.

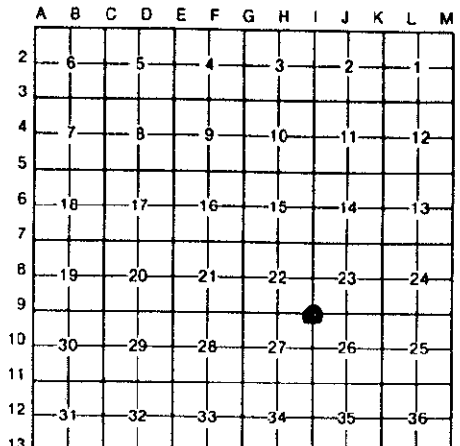

A. Description of original monument and accessories and/or subsequent restoration:
I-9 - Section corner common to Sections 22, 23, 26 & 27, T19N, R14W, Lake County, Mi.

- | | | |
|---------------------------------|---|--|
| <u>1838 - S. Sibley, G.L.O.</u> | <u>1919 - George Johnson, County Surveyor</u> | <u>1965 - Robert Griffin, LS 13684</u> |
| 14" Pine for corner | #1 - 8" Y. Pine 65°W 18' | L.C.R.C. - Liber 01, Page 228. Found railroad rail fish plat and both Johnson's accessories. Replaced with 5" x 36" Concrete Monument. |
| | #2 - 9" B. Oak S83°E 28' | #3 - 13" W. Pine N42°E 67.73' |
| | | #4 - 5" Maple N83°W 97.89' |
| | | #5 - 4" R. Oak N38°W 80.23' |
| | | #1 - 16" R. Pine N65°W 19.60' |
| | | #2 - 18" B. Oak S83°E 27.60' |

B. Description of corner evidence found and/or method applied in restoring or reestablishing corner:
I-9 - Section corner common to Sections 22, 23, 26 & 27, T19N, R14W, Lake County, Mi.

I found a 5" x 36" Concrete Monument 15 feet more or less West of the centerline of North and South dirt road.

Condition of the accessories are as follows: #1 Found in poor condition #2 Found in good condition, #3 Found in good condition, #4 Found in good condition, #5 Found in good condition,

HATIFIED BY THE LAKE CO. PEER REVIEW GROUP
IN ACCORDANCE WITH P.A. 345
CHAIRMAN R.L.W
DATE 11-12-96


C. Description of monument for corner and accessories established to perpetuate locating the position of the corner:
I-9 - Section corner common to Sections 22, 23, 26 & 27, T19N, R14W, Lake County, Mi.

I accepted the 5" x 36" Concrete Monument as a substantial monument for the corner, and is accepted as a careful and faithful re-establishment of the position of the original corner.

- 24" B. Oak S81°E 27.60' (60d spike in N. side) O.B.T. #2
- 21" W. Pine N47°E 67.84' (60d spike in S.E. side) #3
- 10" Maple N79°W 97.87' (dock spike in N. side) #4
- 11" R. Oak N35°W 80.08' (dock spike in E. side) #5
- 8" R. Oak S46°E 57.74' (60d spike in N. side)

Signed by Robert L. Wetherell
24624

Date 11-13-1996

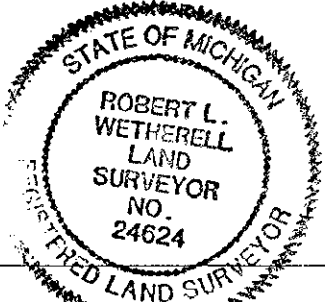

Surveyor's Michigan License No. _____