

LAND CORNER RECORDATION CERTIFICATE  
Filing Requirement of Act 74, Mich. P.A. 1970

LIBER 003 PAGE 0402

For corners in

Lake (County)	Located In:		Corner Code #
	19N	14W	
1. Public Land Survey	T	R	K-11
	T	R	
	T	R	
	T	R	
2. Property Controlling in Section	S	R	
	S	R	
3. Miscellaneous Property in Sec.	S	R	
	S	R	

RECORDED  
LAKE COUNTY, MI.  
NOV 14 11 26 AM '96  
REGISTER OF DEEDS

Register of Deeds Stamp & File Number

4. Lot No. \_\_\_\_\_, Recorded Plat \_\_\_\_\_  
5. Private Claims \_\_\_\_\_

Robert L. Wetherell July 16, 1996

I, \_\_\_\_\_, in a field survey on \_\_\_\_\_, 19\_\_\_\_\_, do hereby certify that under requirements of P.A. 74, Michigan P.A. of 1970, the corner points mentioned in lines 1 and 2 above were in conformance with regulations and rules therefore as required in the current manual of survey instructions of the United States Department of the Interior, Bureau of Land Management or by a decree of a Court of Law and/or that the corner points mentioned in lines 3, 4 and 5 above were in conformance with the rules of the Michigan Board of Land Surveyors or by a Decree of a Court of Law; established, re-established, monumented, re-monumented, recovered, found as expressed below:

**NOTE: Not more than 4 corners, all in the same town and range, may be recorded on this certificate.**

A. Description of original monument and accessories and/or subsequent restoration:

K-11 - Section corner common to Sections 25 26, 35 & 36, T19N, R14W, Lake Co., Mi.

1838 - S. Sibley, G.L.O.

#1 - 12" Pine S44°E 39 Links

#2 - 18" Pine N30°W 50 Links

No record of subsequent restoration since G.L.O.

B. Description of corner evidence found and/or method applied in restoring or reestablishing corner:

K-11 - Section corner common to Sections 25 26, 35 & 36, T19N, R14W, Lake Co., Mi.

I found a barrel stay ring with wood stake. I was unable to recover accessories 1 and 2 above. I measured 5254.89 feet East to the Northeast corner of Section 36 and 5211.66 feet West to the Northwest corner of Section 35 and 5281.58 feet South to South corner of Section 36.

I accepted the stay ring as the corner. I have records that indicate that George Johnson, the late County Surveyor, had used stay rings in other areas throughout the County and assume he is the one who placed this corner.

CERTIFIED BY THE LAKE CO. PEER REVIEW GROUP  
IN ACCORDANCE WITH P.A. 345  
CHAIRMAN *R&W*  
DATE 11-12-96

C. Description of monument for corner and accessories established to perpetuate locating the position of the corner:

K-11 - Section corner common to Sections 25 26, 35 & 36, T19N, R14W, Lake Co., Mi.

I set a 3/4" x 24" Re-bar with Lake County Brass Cap, and is accepted as a careful and faithful re-establishment of the position of the original corner.


10" W. Oak S57°W 111.18' (60d spike in N. side)

8" W. Oak S30°W 134.08' (60d spike in W. side)

6" Cherry N37°W 52.77' (60d spike in W. side)

5" Cherry N85°E 81.44' (60d spike in S. side)

Signed by *Robert L. Wetherell* Date 11-13-1996  
Surveyor's Michigan License No. 24624

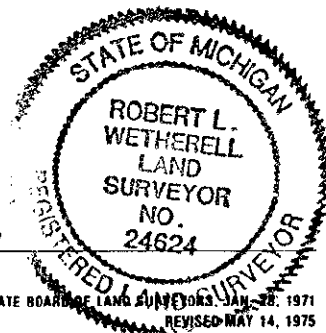

182