

MAY 16 1997

LAND CORNER RECORDATION CERTIFICATE
Filing Requirement of Act 74, Mich. P.A. 1970

LIBER 003 PAGE 0403

For corners in

Lake (County)	Located In:		Corner Code ##
	19N	14W	
1. Public Land Survey	T	R	K-12
	T	R	
	T	R	
	T	R	
2. Property Controlling in Section	S	R	
	S	R	
3. Miscellaneous Property in Sec.	S	R	
	S	R	

RECORDED
LAKE COUNTY, MI.
Nov 14 11 26 AM '96
REGISTER OF DEEDS
Register of Deeds Stamp & File Number

- 4. Lot No. _____, Recorded Plat _____
- 5. Private Claims _____

A	B	C	D	E	F	G	H	I	J	K	L	M
2	6	5	4	3	2	1						
3												
4	7	8	9	10	11	12						
5												
6	16	17	18	15	14	13						
7												
8	19	20	21	22	23	24						
9												
10	30	29	28	27	26	25						
11												
12	31	32	33	34	35	36						
13												

I, Robert L. Wetherell, in a field survey on July 16, 1996, do hereby certify that under requirements of P.A. 74, Michigan P.A. of 1970, the corner points mentioned in lines 1 and 2 above were in conformance with regulations and rules therefore as required in the current manual of survey instructions of the United States Department of the Interior, Bureau of Land Management or by a decree of a Court of Law and/or that the corner points mentioned in lines 3, 4 and 5 above were in conformance with the rules of the Michigan Board of Land Surveyors or by a Decree of a Court of Law; established, re-established, monumented, re-monumented, recovered, found as expressed below:

NOTE: Not more than 4 corners, all in the same town and range, may be recorded on this certificate.

A. Description of original monument and accessories and/or subsequent restoration:

K-12 - 1/4 Corner Common to Sections 35 and 36, T19N, R14W, Lake Co., Mi.

- 1838 - S. Sibley, G.L.O.
- #1 - 12" Pine S11°W 50 Links
- #2 - 12" Pine N9°E 45 Links

No record of subsequent restoration since G.L.O.


B. Description of corner evidence found and/or method applied in restoring or reestablishing corner:

K-12 - 1/4 Corner Common to Sections 35 and 36, T19N, R14W, Lake Co., Mi.

Set corner by single proportionate method. Position fits a possible accessory No. 2 above. Distance North and South is 2640.79 feet.

No other evidence of the corner was recovered.

RATIFIED BY THE LAKE CO. PEER REVIEW GROUP
IN ACCORDANCE WITH P.A. 345
CHAIRMAN R L W
DATE 11-12-96

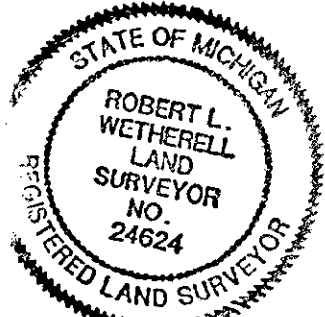

C. Description of monument for corner and accessories established to perpetuate locating the position of the corner:

K-12 - 1/4 Corner Common to Sections 35 and 36, T19N, R14W, Lake Co., Mi.

I set a 3/4" x 24" Re-bar with Lake County Brass Cap, and is accepted as a careful and faithful re-establishment of the position of the original corner.

- 5" R. Pine S86°W 27.98' (60d spike in S. side)
- 10" W. Oak N40°E 41.24' (60d spike in N.W. side)
- 8" W. Pine S87°E 80.78' (60d spike in N. side)
- 7" W. Oak S54°E 35.98' (60d spike in S.W. side)

Signed by Robert L. Wetherell Date 11-13-1996
24624

Surveyor's Michigan License No. _____

183