

MAY 16 1957

COMMISSIONER

LAND CORNER RECORDATION CERTIFICATE
Filing Requirement of Act 74, Mich. P.A. 1970

LIBER 003 PAGE 0404

For corners in

Lake (County)	Located In:		Corner Code #/
	19N	14W	
1. Public Land Survey	T	R	L-11
	T	R	
	T	R	
	T	R	
2. Property Controlling in Section	S	T	R
	S	T	R
3. Miscellaneous Property in Sec.	S	T	R
	S	T	R

REGISTER OF DEEDS

NOV 14 11 27 AM '96

LAKE COUNTY, MI.

RECORDED

Register of Deeds Stamp & File Number

- 4. Lot No. _____, Recorded Plat _____
- 5. Private Claims _____

	A	B	C	D	E	F	G	H	I	J	K	L	M
2	6	5	4	3	2	1							
3													
4	7	8	9	10	11	12							
5													
6	18	17	16	15	14	13							
7													
8	19	20	21	22	23	24							
9													
10	30	29	28	27	26	25							
11													
12	31	32	33	34	35	36							
13													

Robert L. Wetherell July 16, 1996
 I, _____, in a field survey on _____, 19____, do hereby certify that under requirements of P.A. 74, Michigan P.A. of 1970, the corner points mentioned in lines 1 and 2 above were in conformance with regulations and rules therefore as required in the current manual of survey instructions of the United States Department of the Interior, Bureau of Land Management or by a decree of a Court of Law and/or that the corner points mentioned in lines 3, 4 and 5 above were in conformance with the rules of the Michigan Board of Land Surveyors or by a Decree of a Court of Law; established, re-established, monumented, re-monumented, recovered, found as expressed below.

NOTE: Not more than 4 corners, all in the same town and range, may be recorded on this certificate.

A. Description of original monument and accessories and/or subsequent restoration:

L-11 - 1/4 Corner common to Sections 25 and 36, T19N, R14W, Lake Co., Mi.

1838 - s. Sibley, G.L.O.

#1 - 20" Pine N75°W 51 Links

#2 - 30" Pine S38°E 21 Links


No record of subsequent restoration since G.L.O.

B. Description of corner evidence found and/or method applied in restoring or reestablishing corner:

L-11 - 1/4 Corner common to Sections 25 and 36, T19N, R14W, Lake Co., Mi.

No evidence of corner was found. I considered the corner to be lost and set by single proportionate method, 2627.45 feet to each Section corner.

RATIFIED BY THE LAKE CO. PEER REVIEW GROUP
 IN ACCORDANCE WITH P.A. 345
 CHAIRMAN R.L.W.
 DATE 11-12-96

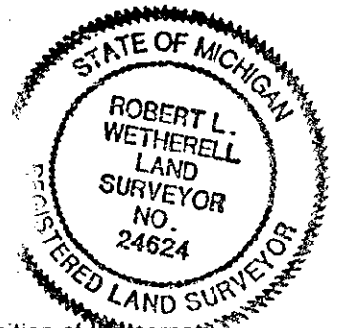

C. Description of monument for corner and accessories established to perpetuate locating the position of the corner:

L-11 - 1/4 Corner common to Sections 25 and 36, T19N, R14W, Lake Co., Mi.

I set a 3/4" x 24" Re-bar with Lake County Brass Cap, and is accepted as a careful and faithful re-establishment of the position of the original corner.

- 9" W. Oak N7°E 9.08' (60d spike in E. side)
- 8" W. Oak S85°W 18.10' (60d spike in S. side)
- 4" R. Oak S16°E 31.17' (60d spike in E. side)
- 8" W. Oak S76°E 32.36' (60d spike in S. side)

Signed by Robert L. Wetherell Date 11-13-1996
 Surveyor's Michigan License No. 24624

next monument to 126

184