

LAND CORNER RECORDATION CERTIFICATE

FILING REQUIREMENT OF ACT 74, MICH. P.A.1970

FOR CORNERS OF--	LOCATED IN--	CORNER CODE NUMBER
1. PUBLIC LAND SURVEY.....	T. 20N ^{N.} [●] R. 11W ^{W.}	G-11, G-12
2. PROPERTY CONTROLLING IN SECTION 33	T. 20N ^{N.} [●] R. 11W ^{W.}	7
3. MISCELLANEOUS PROPERTY IN SECTION.....	T. ^{N.} [●] S. R. ^{E.} ^{W.}	
4. LOT NO., RECORDED PLAT.....		
5. PRIVATE CLAIMS.....		

REGISTER OF DEEDS STAMP AND FILING NUMBER

I, CARL F. ROSER, do hereby certify that under requirements of P.A. 74, Michigan P.A. of 1970, the corner points mentioned in lines 1 and 2 above were, in a field survey on MARCH 5, 1984, established, re-established, monumented, re-monumented, recovered or restored as expressed below and in conformance with regulations and rules therefore as required in the current manual of survey instructions of the United States Department of the Interior, Bureau of Land Management or by a decree of a court of law. Furthermore, that the corner points mentioned in lines 3, 4 and 5 above were, in a field survey on _____, 19____, found, recovered, restored, established or re-established as expressed below and in conformance with the rules of the Michigan State Board of Registration for Land Surveyors or, by a Decree of a Court of law:

A. Description of original monument and accessories and/or subsequent restoration:

7. (CONT.) G.H. JOHNSONS SEC. 34 NOTES CALL FOR 1 1/4" X 5' GAS PIPE.

B. Description of corner evidence found and/or method applied in restoring or re-establishing corner:

- G-11 FD 3" ROUND SOLID IR OVER 30" LONG (BURIED 34"); G.H. JOHNSON RECORDS OF S-34 CALL FOR 4 1/2' OF STEEL SHAFT, 3" DIA. CTR OF E-W DIRT RD IS 6' NORTH. COR IS IN LINE WITH APPROX CTR OF TRAIL RD SOUTHERLY.
- G-12 FD OLD LOOKING 1 1/4" SOLID IR PIN AT NEWER COR FN POST (FN'S N & E) & FN REMAINS SOUTH. PROBABLY G.H. JOHNSON IR, BUT DID NOT FIND HIS WITS. NW'LY EDGE OF COLE CREEK, SOUTH, 71'±; G.H.J. = 70'. W'LY EDGE OF COLE CK, EAST, 29'±. SW'LY EDGE OF COLE CK, NORTH, 29'±.
- 7 FD 1 1/4" PIPE FOR NE COR OF SE-NE OF SEC 33. COR IS IN LINE WITH OLD FN BERM W'LY WITH FN REMAINS. CTR OF N-S TRAIL RD IS E, 6'±. N-S ROW FN IS E, 18'. (CONTINUED)

C. Description of monument for corner and accessories established to perpetuate locating the position of the corner:

G-11	G-12	7
FD 3" RD IR BURIED; RAISED	FD 1 1/4" RD IR; ADDED	FD 1 1/4" PIPE; ADDED
W/ 5/8" X 31" REROD W/RLS CAP.	CED POST W/LOC TAG.	CED POST W/LOC TAG.
4" B CHERRY S45°E 31.58	7" CED N25°W 15.5'	25" B CHERRY N05°W 23.0'
4" SUG MAP S60°W 43.13	9" MAP S60°E 26.9'	7" R PINE S55°W 52.7'
7" SUG MAP N10°W 61.55	8" CED S05°W 14.9'	10" R PINE S75°W 42.3'
SET CED POST		
W/LOC TAG DUE N 33'		

SIGNED BY Carl F. Roser 6/07/84 DATE _____


SURVEYOR'S MICHIGAN REGISTRATION NO. 12028

FOR STATE AND UNITED STATES AGENCIES:

SIGNED BY _____ DATE _____
CHIEF OF SURVEY PARTY

APPROVED AND SIGNED BY _____ DATE _____
MICHIGAN REGISTERED LAND SURVEYOR

SURVEYOR'S MICHIGAN REGISTRATION NO. _____

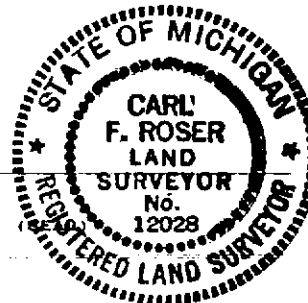

(SEAL)
 DOVER TOWNSHIP
 LAKE COUNTY