

NOV 21 1997

COMMUNICATIONS

LAND CORNER RECORDATION CERTIFICATE
Filing Requirement of Act 74, Mich. P.A. 1970

RECORDED
LAKE COUNTY, MI.

LIBER 004 PAGE 0035

SEP 12 10 31 AM '97

Spencer H. DePaul
REGISTER OF DEEDS

For corners in

Lake (County)	Located In:	Corner Code #
1. Public Land Survey	T 20N R 11W T 20N R 12W T _____ R _____ T _____ R _____	A-9 ✓ M-9
2. Property Controlling in Section	S _____ T _____ R _____ S _____ T _____ R _____	
3. Miscellaneous Property in Sec.	S _____ T _____ R _____ S _____ T _____ R _____	

Register of Deeds Stamp & File Number

4. Lot No. _____, Recorded Plat _____
5. Private Claims _____

	A	B	C	D	E	F	G	H	I	J	K	L	M
2	6		5		4		3		2		1		
3													
4	7		8		9		10		11		12		
5													
6	18		17		16		15		14		13		
7													
8	19		20		21		22		23		24		
9													
10	30		29		28		27		26		25		
11													
12	31		32		33		34		35		36		
13													

I, Robert L. Wetherell, in a field survey on July 3, 1997, do hereby certify that under requirements of P.A. 74, Michigan P.A. of 1970, the corner points mentioned in lines 1 and 2 above were in conformance with regulations and rules therefore as required in the current manual of survey instructions of the United States Department of the Interior, Bureau of Land Management or by a decree of a Court of Law and/or that the corner points mentioned in lines 3, 4 and 5 above were in conformance with the rules of the Michigan Board of Land Surveyors or by a Decree of a Court of Law; established, re-established, monumented, re-monumented, recovered, found as expressed below:

NOTE: Not more than 4 corners, all in the same town and range, may be recorded on this certificate.

A. Description of original monument and accessories and/or subsequent restoration:

- A-9; M-9 - Sec. corner common to Sections 19 & 30, T20N, R11W & Sections 24 & 25, T20N, R12W, Lake Co., Mi.
 - 1838 - John Hodgson, G.L.O. 1911 - George Johnson, Co. Surveyor 1981 - Carl Roser, D.N.R.
 - #1 - 20" Hemlock S8°W 29 Links Stone for corner Found 1/2" Iron by Jim Fletcher's witnesses - L.C.R.C. - L. 02, Pg. 43
 - #2 - 12" Hemlock N43° 8 Links #3 - 8" R. Elm N32°W 48 Links #4 - 2" R. Elm N30°E 90 Links
 - #5 - Nail in top of guardrail post N75°E 18.36'
 - #6 - Nail in top of guardrail post N40°W 28.49'
 - #7 - P. Pole S40° 51.24'
 - #8 - Cedar Post S45° 60.0'

Description of corner evidence found and/or method applied in restoring or reestablishing corner:

A-9; M-9 - Sec. corner common to Sections 19 & 30, T20N, R11W & Sections 24 & 25, T20N, R12W, Lake Co., Mi.

I found a 1/2" re-bar in the centerline of North and South road and in line with old fence to the East. The centerline of a road going West is 18 feet more or less South. Directly under the 1/2" re-bar I found an old 5/8" rod with wood stake. There is approximately 15 feet of road fill in this area.

Condition of the accessories are as follows: #1 Gone, #2 Gone, #3 Gone, #4 Gone, #5 Found in good condition, #6 Found in good condition, #7 Found in good condition, #8 Found in good condition.

This position fits well with 1/16 line fence to the South.

RATIFIED BY THE LAKE CO. PEER REVIEW GROUP
IN ACCORDANCE WITH P.A. 345


CHAIRMAN R.L.W.
DATE 8-27-97

Description of monument for corner and accessories established to perpetuate locating the position of the corner:

A-9; M-9 - Sec. corner common to Sections 19 & 30, T20N, R11W & Sections 24 & 25, T20N, R12W, Lake Co., Mi.

I replaced the 1/2" rod with a 3/4" x 24" re-bar with Lake County Brass Cap, and is accepted as a careful and faithful re-establishment of the position of the original corner.

Guardrail Post N77°E 18.09 (60d spike in top) #5
Guardrail Post S25°E 36.34' (60d spike in top)
Guardrail Post N37°W 28.67' (60d spike in top) #6
P. Pole S42°W 51.35' (nail/washer) #7

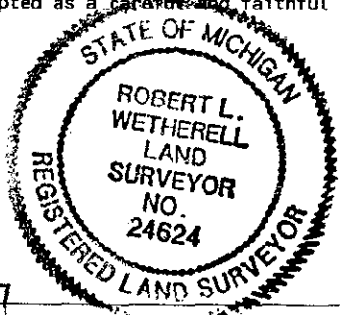

By Robert L. Wetherell
24624

Date 8-27-97

Surveyor's Michigan License No. _____