

NOV 21 1997

COMMISSION

LAND CORNER RECORDATION CERTIFICATE
Filing Requirement of Act 74, Mich. P.A. 1970

RECORDED LAKE COUNTY, MI. LIBER 004 PAGE 0032 SEP 12 10 31 AM '97

For corners in

Table with columns: Lake (County), Located In, Corner Code #. Includes entries for Public Land Survey, Property Controlling in Section, and Miscellaneous Property in Sec.

REGISTER OF DEEDS

Register of Deeds Stamp & File Number

Lot No., Recorded Plat, Private Claims

Grid table with columns A-M and rows 2-13, containing numbers 1-36.

I, Robert L. Wetherell, in a field survey on July 3, 1997, do hereby certify that under requirements of P.A. 74, Michigan P.A. of 1970, the corner points mentioned in lines 1 and 2 above were in conformance with regulations and rules therefore as required in the current manual of survey instructions of the United States Department of the Interior, Bureau of Land Management or by a decree of a Court of Law and/or that the corner points mentioned in lines 3, 4 and 5 above were in conformance with the rules of the Michigan Board of Land Surveyors or by a Decree of a Court of Law; established, re-established, monumented, re-monumented, recovered, found as expressed below.

NOTE: Not more than 4 corners, all in the same town and range, may be recorded on this certificate.

Description of original monument and accessories and/or subsequent restoration:

M-12; A-12 - 1/4 Corner common to Sec. 36, T20N, R12W and Sec. 31, T20N, R11W, Lake Co., Mi.

1838 - John Hodgson, G.L.O.

1905 - J.W. Nicholson, Co. Sur.

1993 - Robert L. Wetherell, LS 24624

#1 - 10" Hemlock N38°W 14 Links

#3 - Pine Stump S38-1/2°E 51.5 Links

Set 1/2" Iron in center of North and South road by doubling over the distance measured from the S.E. cor. of Sec. 36 to an old fence line running East at the S. 1/16 line.

#2 - 8" Hemlock S58°W 20 Links

(Equal distance between Sec. Corners)

#4 - 6" W. Pine N80°E 47.20'

#5 - 8" W. Pine S39°E 46.30'

Description of corner evidence found and/or method applied in restoring or reestablishing corner:

#6 - 6" Maple S20°W 77.88'

#7 - 10" w. oak N46°W 49.8'

M-12; A-12 - 1/4 Corner common to Sec. 36, T20N, R12W and Sec. 31, T20N, R11W, Lake Co., Mi.

I found the 1/2" Capped Iron I had set in 1993. I measured 2636.58 feet South to the Township corner and 2630.14 feet North to the Northeast corner of Section 36.

Condition of the accessories are as follows: #1 Gone #2 Gone, #3 Gone, #4 Found in good condition, #5 Found in good condition, #6 Found in good condition, #7 Found stump.

ATIFIED BY THE LAKE CO. PEER REVIEW GROUP IN ACCORDANCE WITH P.A. 345

CHAIRMAN R.L.W. DATE 8-27-97

Description of monument for corner and accessories established to perpetuate locating the position of the corner:

M-12; A-12 - 1/4 Corner common to Sec. 36, T20N, R12W and Sec. 31, T20N, R11W, Lake Co., Mi.


I replaced the 1/2" Capped Iron with a 3/4" x 24" re-bar with Lake County Brass Cap, and is accepted as a careful and faithful re-establishment of the position of the original corner.

6" W. Pine N80°E 47.20' (60d spike in N. side) #4

8" W. Pine S39°E 46.30' (60d spike in N. side) #5

6" Maple S20°W 77.88' (60d spike in E. side) #6

7" W. Pine N32°W 60.27' (60d spike in E. side)

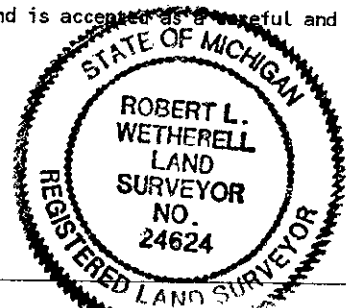

Surveyed by Robert L. Wetherell

Date 8-27-97

Surveyor's Michigan License No. 24624