

NOV 15 1994

LAND CORNER RECORDATION CERTIFICATE

Filing Requirement of Act 74 Mich. P.A. 1970

LIBER 003 PAGE 0222

For corners in Lake

COMMISSION

RECORDED LAKE COUNTY, MI. REGISTER OF DEEDS REGISTER OF DEEDS Stamp & File Number

Table with columns: (County), Located In: (T, S, R, T, R), Corner Code # (A-13)

4. Lot No. , Recorded Plat
5. Private Claims

Grid table with columns A-M and rows 2-13

I, Robert L. Wetherell, in a field survey on May 24, 1994, do hereby certify that under requirements of P.A. 74, Michigan P.A. of 1970, the corner points mentioned in lines 1 and 2 above were in conformance with regulations and rules therefore as required in the current manual of survey instructions of the United States Department of the Interior, Bureau of Land Management or by a decree of a Court of Law and/or that the corner points mentioned in lines 3, 4 and 5 above were in conformance with the rules of the Michigan Board of Land Surveyors or by a Decree of a Court of Law; established, re-established, monumented, re-monumented, recovered, found as expressed below:

NOTE: Not more than 4 corners, all in the same town and range, may be recorded on this certificate.

A. Description of original monument and accessories and/or subsequent restoration:

- A-13 - (S.W. corner Section 31, T20N, R11W, Lake Co., Mi.)
1836 - John Hodgson, D.S., G.L.O.
1905 - J.W. Nicholson, Co. Surveyor
UNDATED - G. JOHNSON, L.S. 504


(SEE OVER FOR CONTINUATION OF "A" - DESCRIPTION OF ORIGINAL MONUMENT)

B. Description of corner evidence found and/or method applied in restoring or reestablishing corner:

A-13 - (S.W. corner Section 31, T20N, R11W, Lake Co., Mi.)
I found 3/4" pipe under 1/2" capped re-bar (could not identify number), in the center of the North and South blacktop road and center of an East and West Gravel Road. I measured 2463.41 feet to the South 1/4 corner of Section 31, and 2528.8 feet to the North 1/4 corner of Section 6, T19N, R11W, and 2634.64 feet to the West 1/4 corner of Section 31, T20N, R11W. Accessories 1 thru 5 were all destroyed with road construction.

C. Description of monument for corner and accessories established to perpetuate locating the position of the corner:

A-13 - (S.W. corner Section 31, T20N, R11W, Lake Co., Mi.)
I set a 3/4" x 24" re-bar with Lake County Brass Cap, and is accepted as a careful and faithful re-establishment of the position of the original corner.
28" Maple S88°E 302.06' (60d spike in S. side of tree).
30" Maple S2°E 376.14' (60d spike in W. side of tree).
9" R. Oak N18°E 238.83' (60d spike in E. side of tree).
7" Elm N28°W 144.46' (60d spike in N.E. side of tree).

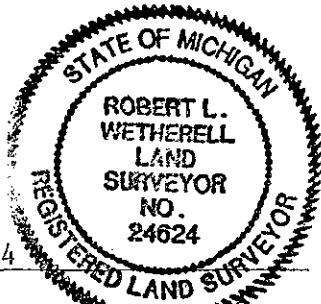

Signed by Robert L. Wetherell Date October 4, 1994
Surveyor's Michigan License No. LS 24624

CONTINUATION OF "A" - DESCRIPTION OF ORIGINAL MONUMENT AND ACCESSORIES AND/OR SUBSEQUENT RESTORATION:

1950 - George Blass, L.S. 5489
Making road survey for County.
Found 3/4" pipe with stone around.
#4 - 20" Maple S62°E 27.50'
#5 - 14" Maple N75°E 89.50'

1987 - Clinton E. Cole, L.S. 17615
Working in Sec. 6, T19N R11W.
Shows distance of 2528.66' to the
N.1/4 corner of Section 6.
No accessories given.

SUBMITTED
REMONUMENTATION

NOV 15 1994

COMMISSION