

MAY 16 1997

LAND CORNER RECORDATION CERTIFICATE

Filing Requirement of Act 74, Mich. P.A. 1970

LIBER 003 PAGE 0420


For corners in

Lake (County)	Located In:	Corner Code #
1. Public Land Survey	T 20N R 11W	D-5
	T R	
	T R	
	T R	
2. Property Controlling in Section	S T R	
	S T R	
3. Miscellaneous Property in Sec.	S T R	
	S T R	

RECORDED
LAKE COUNTY, MI.
Dec 16 10 27 AM '96
REGISTER OF DEEDS

Register of Deeds Stamp & File Number

- 4. Lot No. _____, Recorded Plat _____
- 5. Private Claims _____

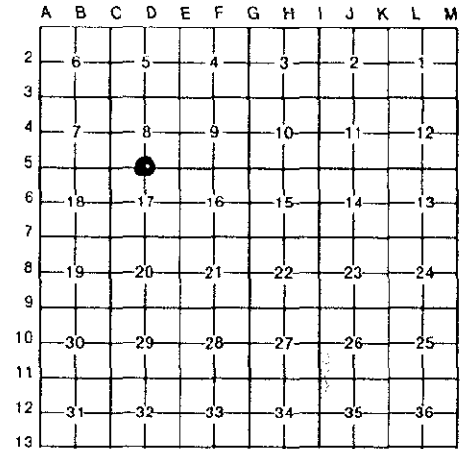

I, Robert L. Wetherell, in a field survey on September 19, 19 96, do hereby certify that under requirements of P.A. 74, Michigan P.A. of 1970, the corner points mentioned in lines 1 and 2 above were in conformance with regulations and rules therefore as required in the current manual of survey instructions of the United States Department of the Interior, Bureau of Land Management or by a decree of a Court of Law and/or that the corner points mentioned in lines 3, 4 and 5 above were in conformance with the rules of the Michigan Board of Land Surveyors or by a Decree of a Court of Law; established, re-established, monumented, re-monumented, recovered, found as expressed below:

NOTE: Not more than 4 corners, all in the same town and range, may be recorded on this certificate.

A. Description of original monument and accessories and/or subsequent restoration:

D-5 - 1/4 Corner common to Sections 8 & 17, T20N, R11W, Lake Co., Mi.

1838 - S. Sibley, G.L.O.
4" Maple N58-1/2°W 12 Links
4" Cherry S3-1/2°E 20 Links

1974 - Jim Fletcher (Granger Eng.)
Broke Sections 17 & 18 recovering only the N.W. cor. Sec. 18 and the N.E. & S.E. corners Sec. 17. He did not set an other Government corners.

1993 - Robert L. Wetherell, LS 24624
L.C.R.C. - Liber 03, Page 172
Set 1/2" Iron by single proportionate method. Act 132 Survey recorded in Liber 03, Page 413.

B. Description of corner evidence found and/or method applied in restoring or reestablishing corner:

D-5 - 1/4 Corner common to Sections 8 & 17, T20N, R11W, Lake Co., Mi.

I found the 1/2" iron I set in 1993. In reviewing my notes from 1993, I discovered I had made an error in setting the Northwest corner of Section 17 (see L.C.R.C. on N.W. cor. Sec 17). I, therefore, used the correct Northwest corner and moved this corner 0.65 feet East of the location I had established in 1993.

G.L.O. distance East and West to respective Section corners = 2638.68 feet
Measured distance East and West to respective Section corners - 2636.77 feet

WITNESSED BY THE STATE OF MICHIGAN SURVEYOR GROUP
IN ACCORDANCE WITH ACT 345
DATE 12-12-96



C. Description of monument for corner and accessories established to perpetuate locating the position of the corner:

D-5 - 1/4 Corner common to Sections 8 & 17, T20N, R11W, Lake Co., Mi.

I set a 3/4" x 24" re-bar with Lake County Brass Cap, and is accepted as a careful and faithful re-establishment of the position of the original corner.

- 12" Hemlock N1°W 87.23' (60d spike in E. side)
- Maple Clump N26°E 43.41' (60d spike in W. side)
- 8" Hemlock N82°E 70.09' (60d spike in N. side)
- 6" Cherry S3°E 30.96' (60d spike in W. side)

Signed by Robert L. Wetherell

Date 12-13-1996

Surveyor's Michigan License No. 24624