

SURVEY & REMONUMENTATION

SEP 01 1999

LAND CORNER RECORDATION CERTIFICATE
 Filing Requirement of Act 74, Mich. P.A. 1970

LIBER 003 PAGE 0422

For corners in **SECTION**

Lake (County)	Located In:	Corner Code #
1. Public Land Survey	T 20N R 11W	E-5
	T R	
	T R	
	T R	
2. Property Controlling in Section	S T R	
	S T R	
3. Miscellaneous Property in Sec.	S T R	
	S T R	

REGISTERED
 LAKE COUNTY, MI.
 DEC 16 10 27 AM '96
 REGISTER OF DEEDS
 Register of Deeds Stamp & File Number

4. Lot No. _____, Recorded Plat _____
 5. Private Claims _____

	A	B	C	D	E	F	G	H	I	J	K	L	M
2	6	5	4	3	2	1							
3													
4	7	8	9	10	11	12							
5													
6	18	17	16	15	14	13							
7													
8	19	20	21	22	23	24							
9													
10	30	29	28	27	26	25							
11													
12	31	32	33	34	35	36							
13													

I, Robert L. Wetherell, in a field survey on September 19, 19 96, do hereby certify that under requirements of P.A. 74, Michigan P.A. of 1970, the corner points mentioned in lines 1 and 2 above were in conformance with regulations and rules therefore as required in the current manual of survey instructions of the United States Department of the Interior, Bureau of Land Management or by a decree of a Court of Law and/or that the corner points mentioned in lines 3, 4 and 5 above were in conformance with the rules of the Michigan Board of Land Surveyors or by a Decree of a Court of Law; established, re-established, monumented, re-monumented, recovered, found as expressed below:

NOTE: Not more than 4 corners, all in the same town and range, may be recorded on this certificate.

A. Description of original monument and accessories and/or subsequent restoration:

E-5 - Section corner common to Sections 8, 9, 16 & 17, T20N, R11W, Lake Co., Mi.

- | | | |
|--|---|--------------------------------------|
| <u>1838 - S. Sibley, G.L.O.</u> | <u>1907 - J.W. Nicholson, County Surveyor</u> | <u>1956 - George Blass, 5489</u> |
| <u>#1 - 10" Hemlock S11°E 10 Links</u> | <u>Found post and fallen Government witness tree. Set Iron Marker</u> | <u>3/4" x 30" Iron Pipe</u> |
| <u>#2 - 10" Hemlock N79°W 17 Links</u> | <u>#3 - 4" B. Oak S59°W 22 Links</u> | <u>#5 - 12" Hemlock N67°W 27.80'</u> |
| | <u>#4 - 5" W. Pine S50-1/2°E 31 Links</u> | <u>#4 - 14" W. Pine S50°E 20.46'</u> |
| | | <u>#3 - 16" B. Oak S59°W 14.90'</u> |

(SEE OVER FOR CONTINUATION OF "A")

B. Description of corner evidence found and/or method applied in restoring or reestablishing corner:

E-5 - Section corner common to Sections 8, 9, 16 & 17, T20N, R11W, Lake Co., Mi.

I found 5" Square concrete monument below surface of dirt road.

Condition of the accessories are as follows: #1 Gone, #2 Gone, #3 Found dead 20" B. Oak, #4 Found 14" W. Pine, #5 Found Leaning, #6 Found Stump, #7 Found in good condition, #8 Gone.

VALIDATED BY THE LAKE CO. PEER REVIEW GROUP
 IN ACCORDANCE WITH P.A. 345
 CHAIRMAN

DATE 12-12-96
R.L.W.

C. Description of monument for corner and accessories established to perpetuate locating the position of the corner:

E-5 - Section corner common to Sections 8, 9, 16 & 17, T20N, R11W, Lake Co., Mi.


I set a 3/4" x 24" re-bar with Lake County Brass Cap directly over 5" Concrete Monument and is accepted as a careful and faithful perpetuation of the original corner.

- 15" Maple S82°W 42.87' (60d spike in S. side)
- 10" Maple N11°W 46.62' (60d spike in E. side)
- 13" Maple N39°E 53.70' (60d spike in N.W. side)
- 12" R. Pine N67°E 117.05' (60d spike in N. side) #7

Signed by Robert L. Wetherell

Date 12-13-1996

Surveyor's Michigan License No. 24624

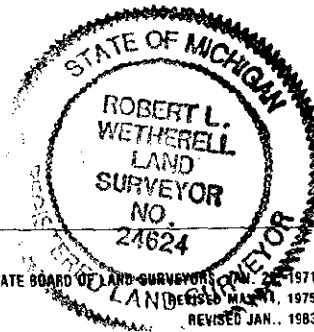

195

SURVEY &
REMONUMENTATION

SEP 01 1999

LIBER003 PAGE 0423

SECTION

CONTINUATION OF "A" - DESCRIPTION OF ORIGINAL MONUMENT AND ACCESSORIES AND/OR SUBSEQUENT RESTORATION:

1963 - Robert Griffin, U.S.F.S.

L.C.R.C. - Liber 01, Page 249

Replaced 3/4" Pipe with 5" Square Concrete Monument

#6 - 6" Cedar N71°W 86.9'

#5 - 12" Hemlock N66°W 28.00'

#7 - 6" R. Pine N62°E 117.05'

#4 - 15" W. Pine S48°E 20.25'

1974 - James Fletcher, LS 19830

Found 5" Square Concrete Monument

#3 - 20" B. Oak S55°W 15.34'

#8 - 16" Hemlock N25°W 30.70'

#4 - 18" W. Pine S48°E 20.35'