

NOV 21 1997

COMMISSION

LAND CORNER RECORDATION CERTIFICATE
Filing Requirement of Act 74, Mich. P.A. 1970


RECORDED LAKE COUNTY, MI. LIBER 004 PAGE 0036 SEP 12 10 31 AM '97

Form with fields for Lake (County), Located in (20N, 11W), Corner Code (#), and numbered sections 1-5 for Public Land Survey, Property Controlling, etc.

Signature of Register of Deeds and REGISTER OF DEEDS title.

Register of Deeds Stamp & File Number

Robert L. Wetherell, July 2, 1997, do hereby certify that under requirements of P.A. 74, Michigan P.A. of 1970, the corner points mentioned in lines 1 and 2 above were in conformance with regulations and rules therefore as required in the current manual of survey instructions of the United States Department of the Interior, Bureau of Land Management or by a decree of a Court of Law and/or that the corner points mentioned in lines 3, 4 and 5 above were in conformance with the rules of the Michigan Board of Land Surveyors or by a Decree of a Court of Law; established, re-established, monumented, re-monumented, recovered, found as expressed below.

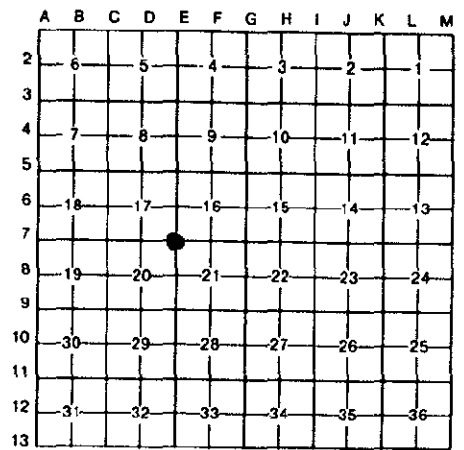

NOTE: Not more than 4 corners, all in the same town and range, may be recorded on this certificate.

A. Description of original monument and accessories and/or subsequent restoration:

- E-7 - Section corner common to Sections 16, 17, 20 & 21, T20N, R11W, Lake Co., Mi.
1838 - S. Sibley, G.L.O. 1967 - George Blass, LS 5489 1993 - Jerry Taylor, LS 32342
#1 - 12" Beech S6°E 12 Links Found 2-1/2" Iron Pipe. Replaced with 4" x 36" Concrete Monument L.C.R.C. - Liber 03, Pg. 193
#2 - 8" Beech N10°W 19 Links #5 - 14" Maple N40°W 45.55' #6 - N.E. Cor. Garage S47°W 47.7'
1907 - J.W. Nicholson, Co. Sur. #4 - 32" Maple S75°W 71.30' #9 - 16" Maple N32°E 56.16'
Located from corner of School yard #6 - N.E. Cor. Garage S47°W 47.63' #10 - 10" W. Ash N11°W 147.67'
#3 - 8" Sugar S87°E 60 Links #7 - 12" Maple S22°E 53.45' #11 - 16" Beech S37°E 51.10'
#4 - 10" Sugar S71-1/2°W 111 Links #8 - U.S.G.S. - U.E. Marker in 28" Hemlock
S08°E 36.90'

3. Description of corner evidence found and/or method applied in restoring or reestablishing corner:

E-7 - Section corner common to Sections 16, 17, 20 & 21, T20N, R11W, Lake Co., Mi.

I found Blass's Concrete Monument in intersection of roads East, West and North.

Condition of the accessories are as follows: #1 gone, #2 Gone, #3 gone, #4 Found stump, #5 gone, #6 Found in good condition, #7 Found in good condition, #8 Found in good condition, #9 Found in good condition, #10 Found in poor condition, #11 Found in good condition,

RATIFIED BY THE LAKE CO. PEER REVIEW GROUP IN ACCORDANCE WITH P.A. 345 CHAIRMAN R.L.W. DATE 8-27-97

Description of monument for corner and accessories established to perpetuate locating the position of the corner:

E-7 - Section corner common to Sections 16, 17, 20 & 21, T20N, R11W, Lake Co., Mi.

I accepted the 4" x 36" Brass Capped Monument as a substantial marker for the corner, and is accepted as a careful and faithful re-establishment of the position of the original corner.

- N.E. corner of Concrete Block Garage S47°W 47.70' #6
16" Maple N37°E 56.01 #9
16" Beech S31°E 51.06' #11
U.S.G.S. - U.E. in root of 32" Hemlock S6°E 36.88' #8

Signed by Robert L. Wetherell Date 8-27-97

Surveyor's Michigan License No. 24624

