

Surveyor &
REMONUMENTATION

NOV 21 1997

COMMISSION

LAND CORNER RECORDATION CERTIFICATE
Filing Requirement of Act 74, Mich. P.A. 1970

RECORDED
LAKE COUNTY, MI.
LIBER 004 PAGE 0038

SEP 12 10 31 AM '97

For corners in

Lake (County)	Located In:		Corner Code #
	20N	11W	
1. Public Land Survey	T _____	R _____	F-5
	T _____	R _____	
	T _____	R _____	
	T _____	R _____	
2. Property Controlling in Section	S _____	T _____	R _____
	S _____	T _____	R _____
3. Miscellaneous Property in Sec.	S _____	T _____	R _____
	S _____	T _____	R _____

James H. Steinhilber
REGISTER OF DEEDS

Register of Deeds Stamp & File Number

4. Lot No. _____, Recorded Plat _____
5. Private Claims _____

Robert L. Wetherell July 2, 97

A	B	C	D	E	F	G	H	I	J	K	L	M
2	6	5	4	3	2	1						
3												
4	7	8	9	10	11	12						
5												
6	18	17	16	15	14	13						
7												
8	19	20	21	22	23	24						
9												
10	30	29	28	27	26	25						
11												
12	31	32	33	34	35	36						
13												

I, _____, in a field survey on _____, 19 _____, do hereby certify that under requirements of P.A. 74, Michigan P.A. of 1970, the corner points mentioned in lines 1 and 2 above were in conformance with regulations and rules therefore as required in the current manual of survey instructions of the United States Department of the Interior, Bureau of Land Management or by a decree of a Court of Law and/or that the corner points mentioned in lines 3, 4 and 5 above were in conformance with the rules of the Michigan Board of Land Surveyors or by a Decree of a Court of Law; established, re-established, monumented, re-monumented, recovered, found as expressed below:

NOTE: Not more than 4 corners, all in the same town and range, may be recorded on this certificate.

A. Description of original monument and accessories and/or subsequent restoration:

F-5 - 1/4 Corner common to Sections 9 and 16, T20N, R11W, Lake Co., Mi.

1838 - S. Sibley, G.L.O.	1956 - George Blass, LS 5489	1963 - Robert A. Griffin, LS 13584
#1 - 10" Hemlock S45°E 20 Links	1/2" x 18" Pipe	L.C.R.C. - Liber 01, Page 250
#2 - 10" Beech N20°W 16 Links	Corner was found from witnesses of J.W. Nicholson taken 1907. Replaced wood stake with pipe.	Found 1/2" pipe and Blass's accessories: replaced with 5" Square Concrete Monument
	#3 - 16" W. Oak N73°E 24.05'	#3 - 13" W. Oak N71°E 24.70'
	#4 - 14" R. Oak N70°W 15.66'	#4 - 13" R. Oak N70°W 15.95'
	#5 - 4" Maple N14°W 31.44'	#5 - 4" Maple N14°W 31.65'
		#6 Cedar Post - South 1.5'

B. Description of corner evidence found and/or method applied in restoring or reestablishing corner:

F-5 - 1/4 Corner common to Sections 9 and 16, T20N, R11W, Lake Co., Mi.

I found a 5" Square Concrete Monument by Griffin approximately 65 feet South of East and West dirt road.
Condition of the accessories are as follows: #1 gone, #2 gone, #3 Found in good condition, #4 Found in good condition, #5 Found in good condition, #6 gone.


RATIFIED BY THE LAKE CO. PEER REVIEW GROUP
IN ACCORDANCE WITH P.A. 345
CHAIRMAN *R.L.W.*
DATE *8-27-97*

C. Description of monument for corner and accessories established to perpetuate locating the position of the corner:

F-5 - 1/4 Corner common to Sections 9 and 16, T20N, R11W, Lake Co., Mi.

I accepted the 5" x 60" Concrete Monument as a substantial marker for the corner, and is accepted as a careful and faithful re-establishment of the position of the original corner.

- 19" R. Oak N69°W 16.02' (dock spike in S. side) #4
- 17" W. Oak N74°E 24.89' (dock spike in S. side) #3
- 8" Maple N11°W 31.72' (dock spike in W. side) #5
- 9" R. Pine N01°E 138.85' (60d spike in E. side)

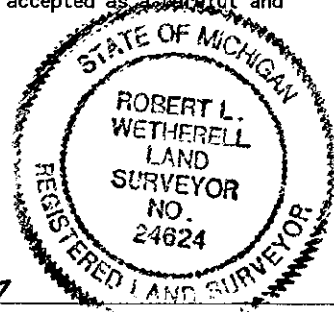

Signed by *Robert L. Wetherell* Date *8-27-97*

Surveyor's Michigan License No. _____